


STATE	PROJECT DESIGNATION	YEAR	SHEET NO.	TOTAL SHEETS
ALASKA	SOS-3(009)	1978	3	11



Earthwork Equation:  
 Embankment = Unclassified Excavation + Borrow x Shrink Factor 0.87

Embankment = ~~2755~~ All Req'd  
 Excavation = ~~627~~ All Req'd  
 Borrow = ~~3170~~ All Req'd  
 -2 Inch Select Material = ~~260~~ All Req'd

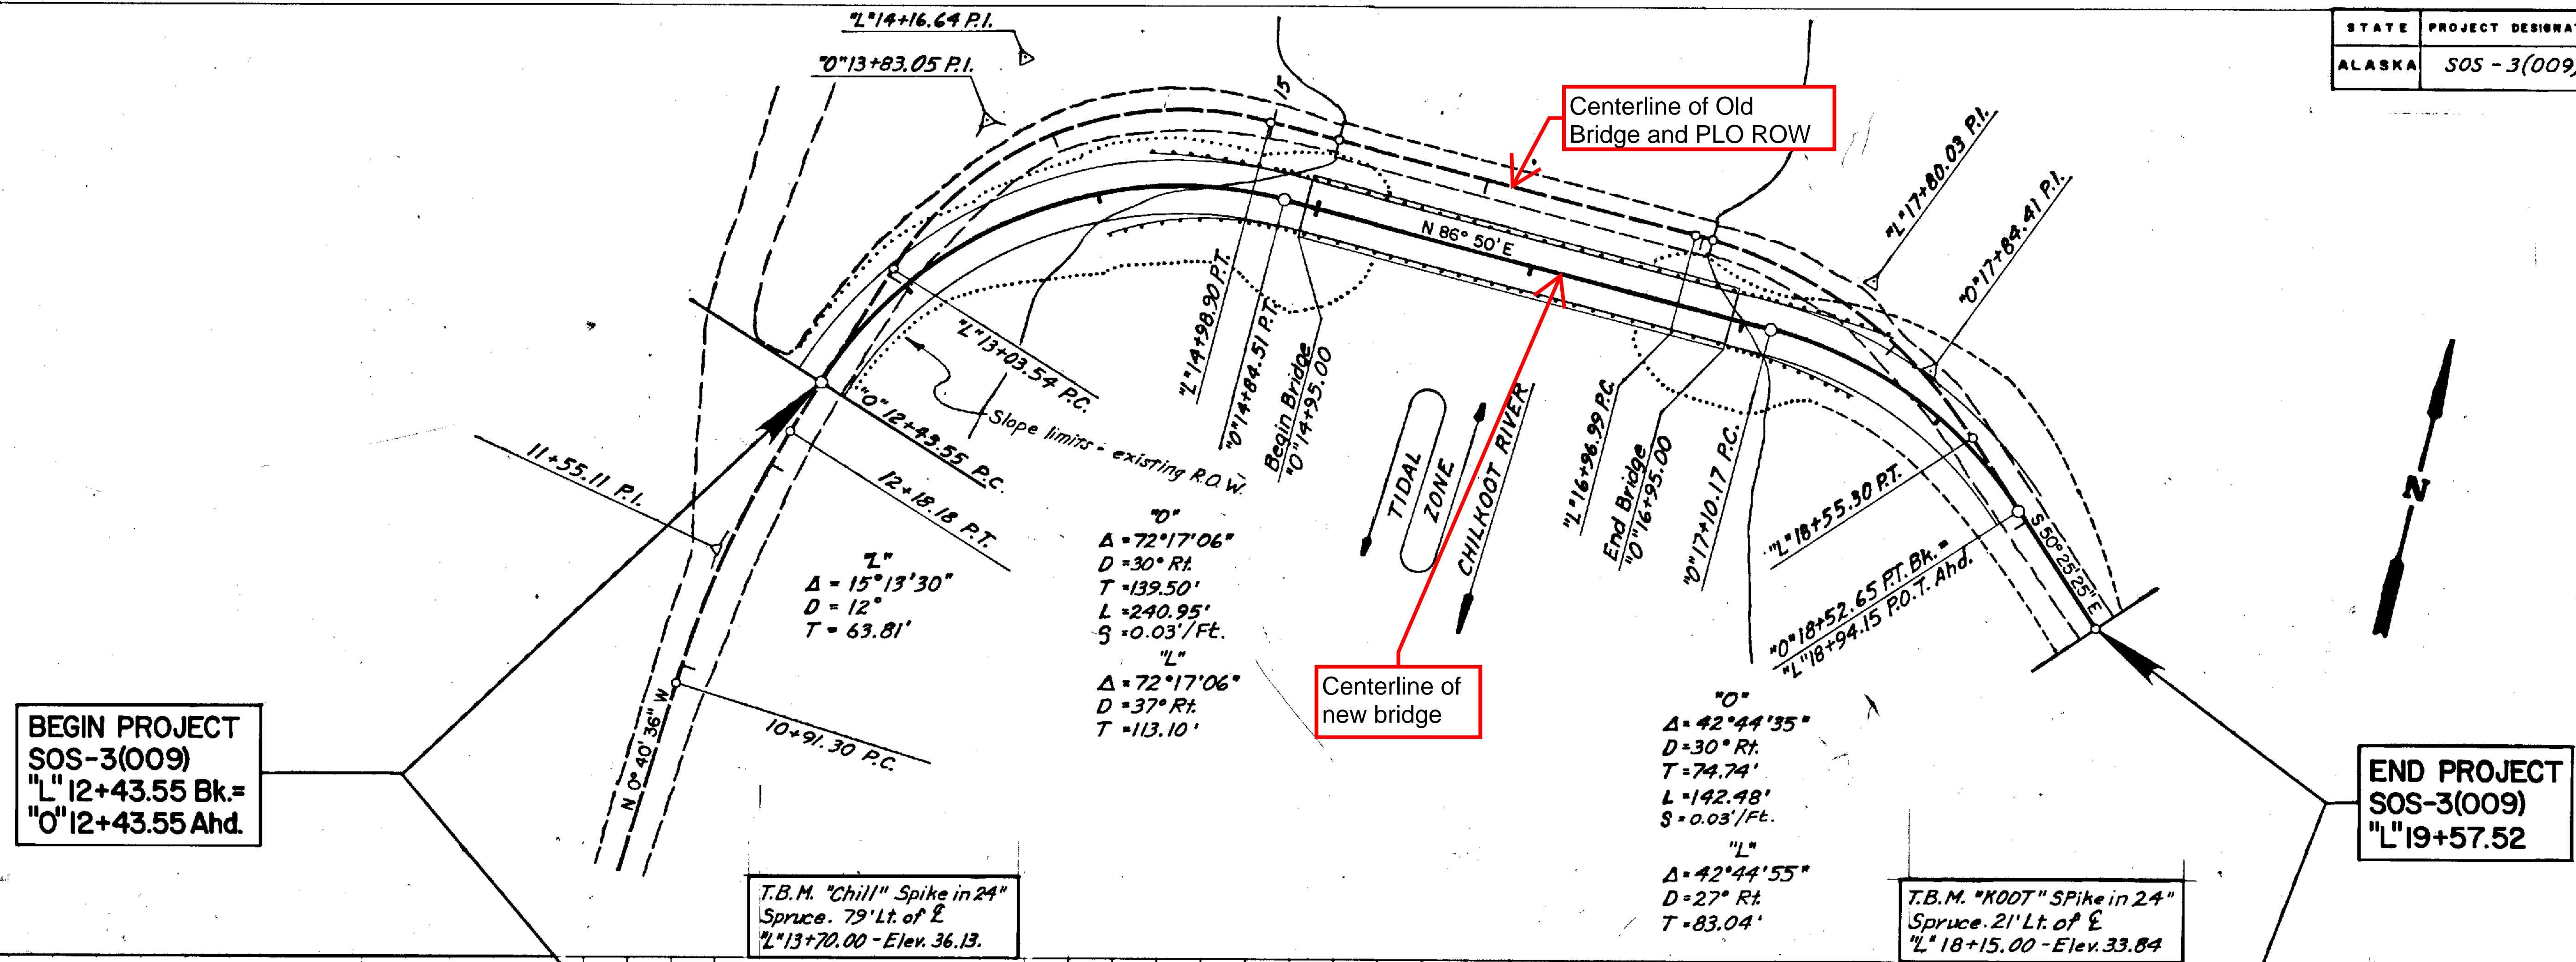