
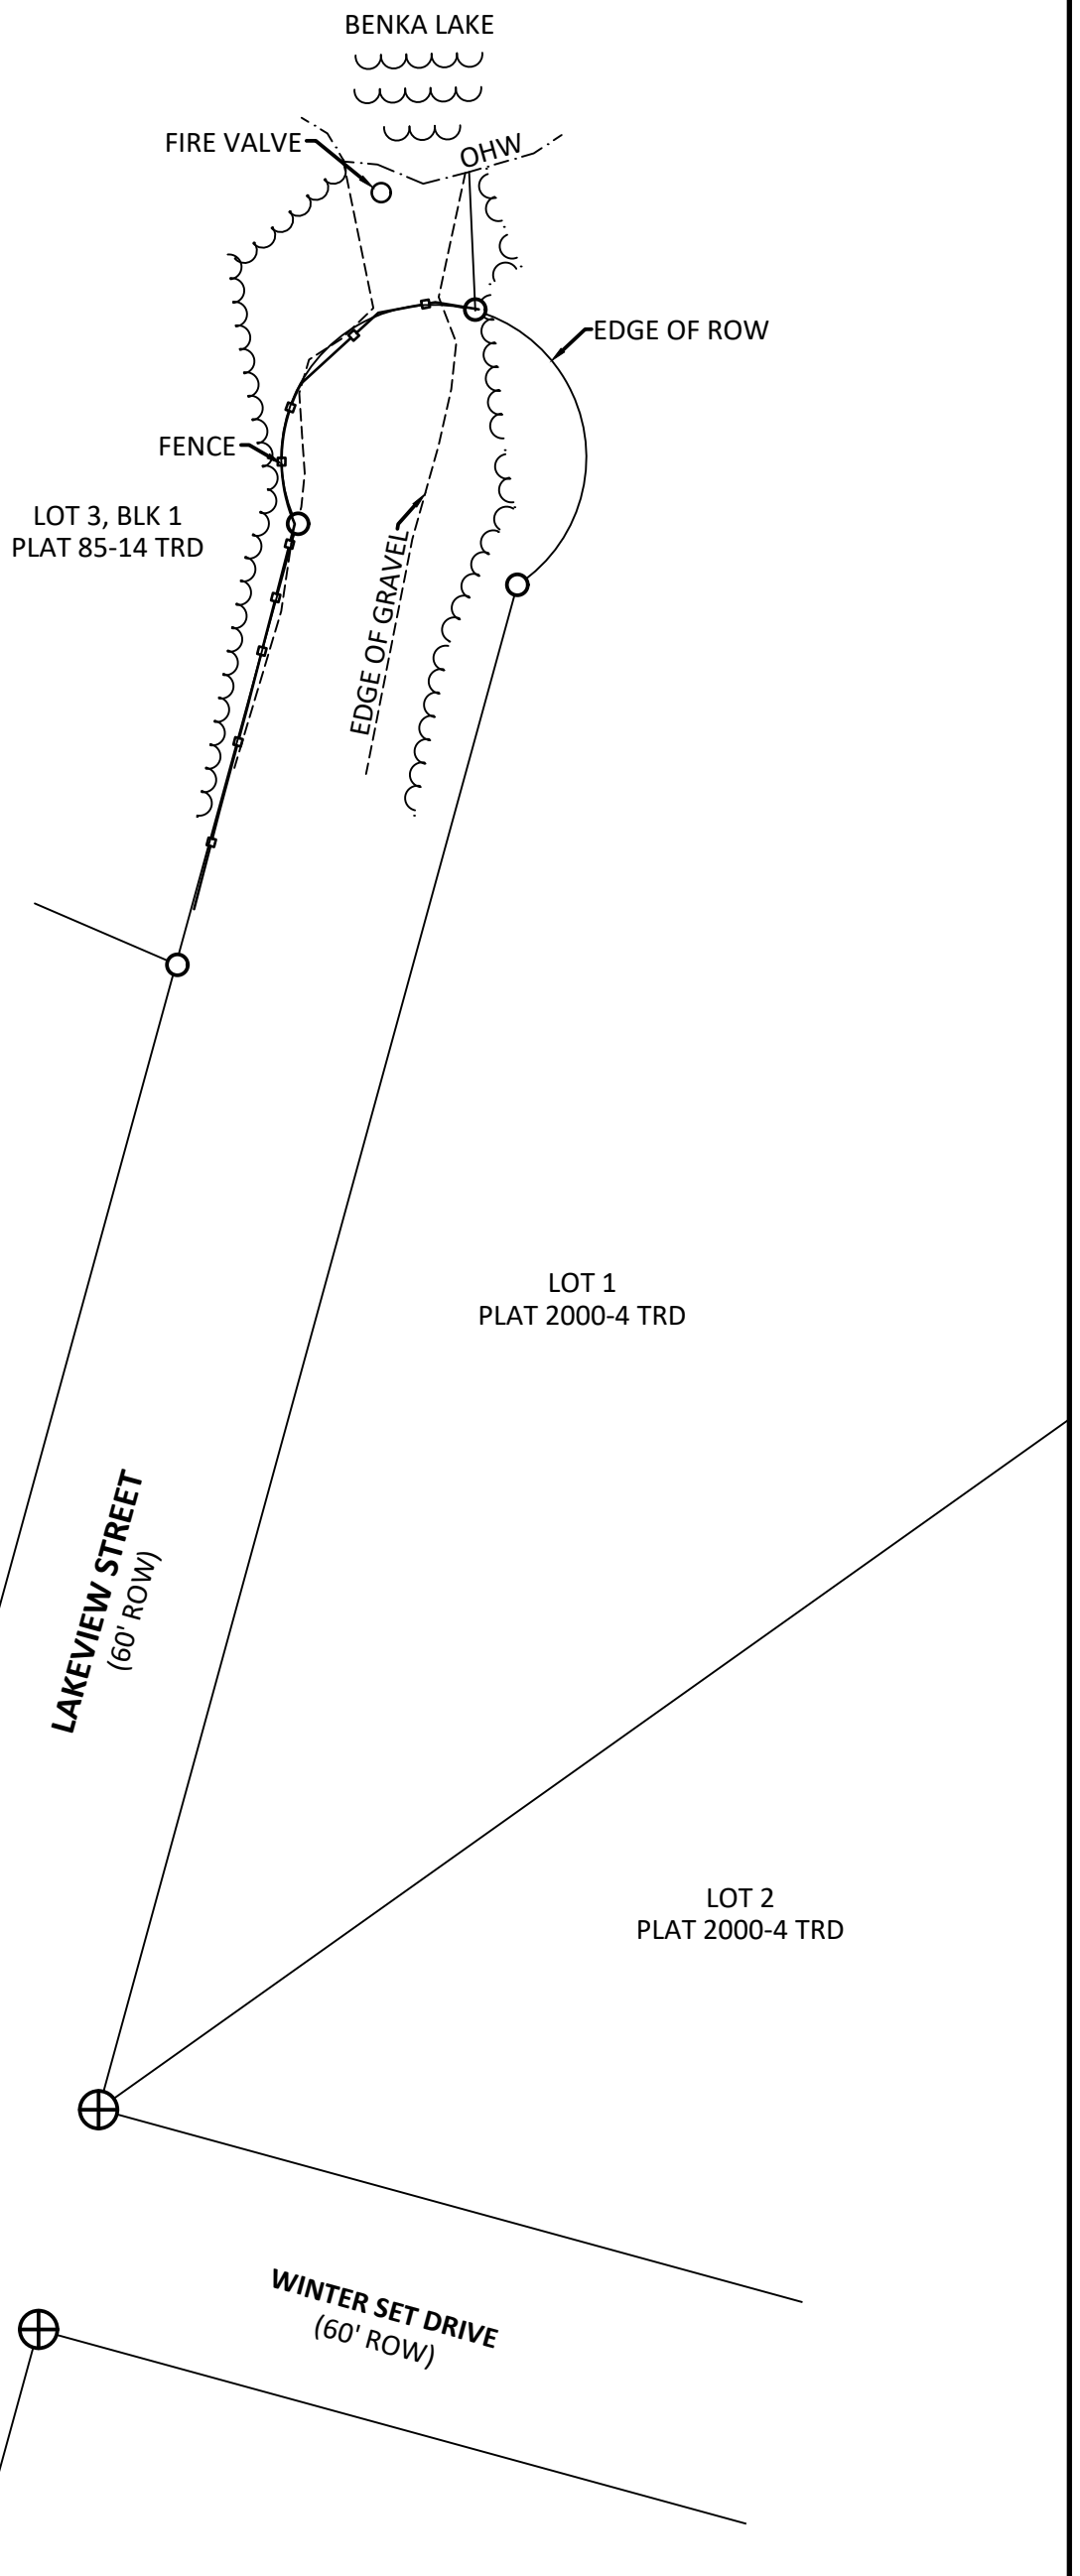
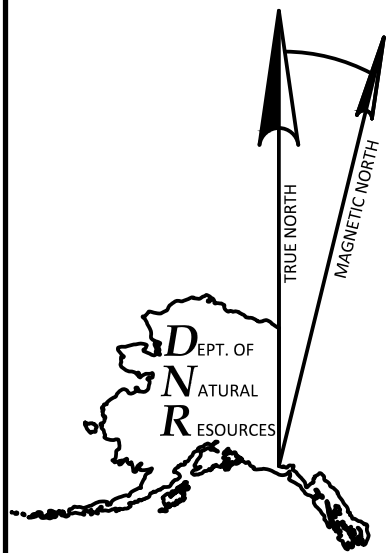


VICINITY MAP
SCALE 1" = 1 MILE

USGS QUADS: TALKEETNA MOUNTAINS A-6 NW AK
TALKEETNA A-1 NE AK

GRAPHIC SCALE



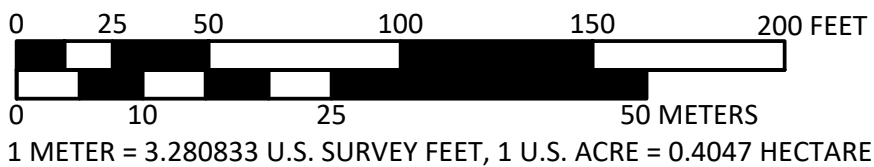


**BENKA LAKE
AS-BUILT SURVEY
TALKEETNA, ALASKA**

LOCATED WITHIN SECTION 9,
TOWNSHIP 24 NORTH, RANGE 4 WEST,
SEWARD MERIDIAN, ALASKA

LEGEND	
⊕	PRIMARY MONUMENT RECOVERED
○	SECONDARY MONUMENT RECOVERED
---	UNSURVEYED
—	SURVEYED
— OHW —	ORDINARY HIGH WATER
~~~~~	EDGE OF VEGETATION
ROW	RIGHT OF WAY
TRD	TALKEETNA RECORDING DISTRICT

SCALE: 1"=50'
DRAWN BY: KJB
DATE: 10/6/2023
PAGE: 1 OF 2
DEPARTMENT OF NATURAL RESOURCES DIVISION OF MINING, LAND & WATER 550 WEST 7TH AVE., SUITE 650 ANCHORAGE ALASKA 99501 (907) 263-6266

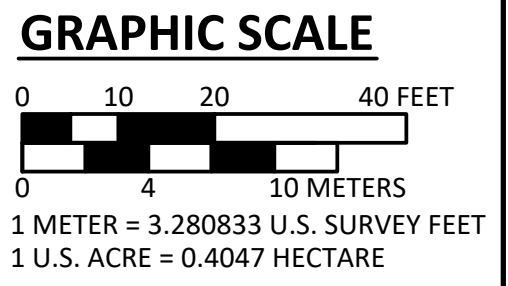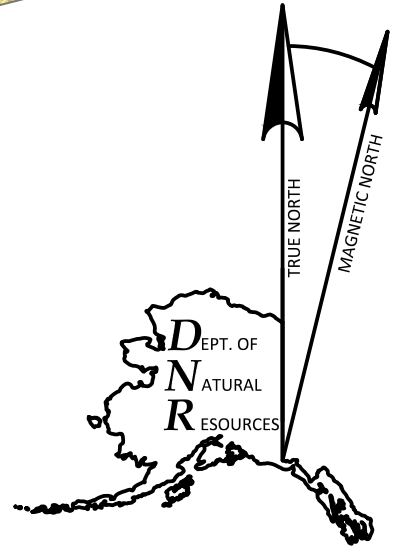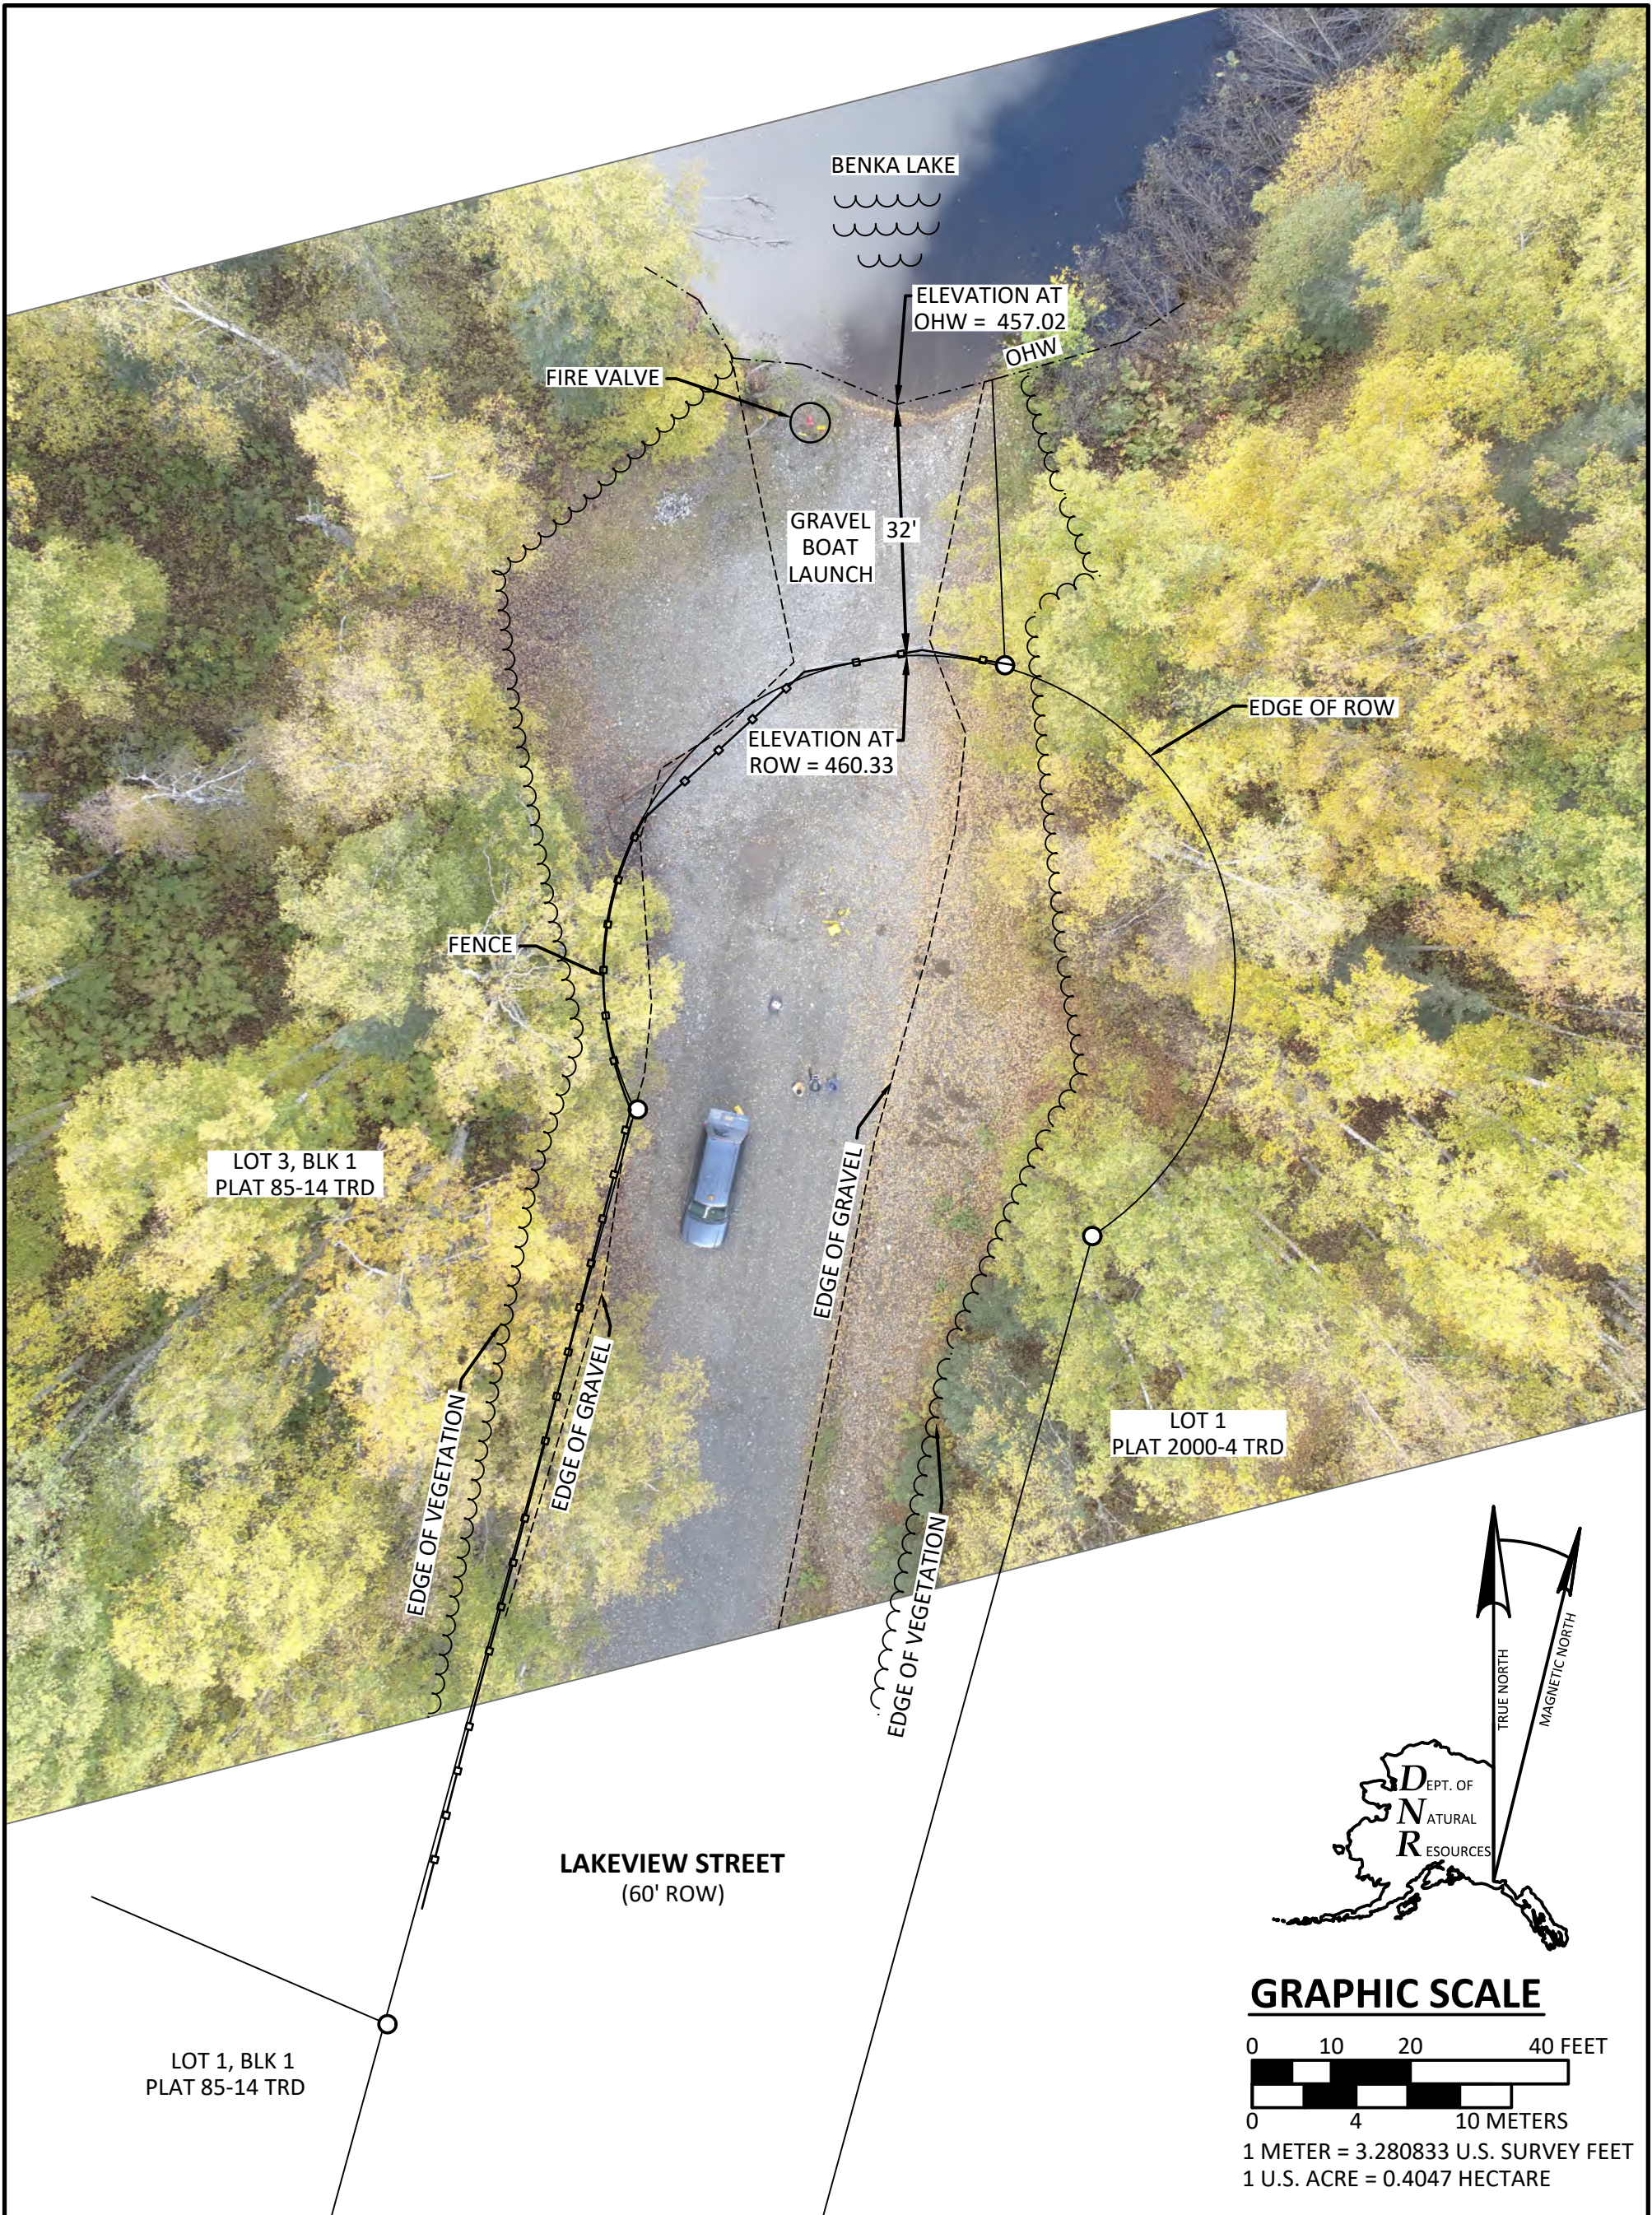

# BENKA LAKE AS-BUILT SURVEY TALKEETNA, ALASKA

LOCATED WITHIN SECTION 9,  
TOWNSHIP 24 NORTH, RANGE 4 WEST,  
SEWARD MERIDIAN, ALASKA

LEGEND	
⊕	PRIMARY MONUMENT RECOVERED
○	SECONDARY MONUMENT RECOVERED
---	UNSURVEYED
—	SURVEYED
— . OHW . —	ORDINARY HIGH WATER
~~~~~	EDGE OF VEGETATION
ROW	RIGHT OF WAY
TRD	TALKEETNA RECORDING DISTRICT

SCALE: 1"=20'
DRAWN BY: KJB
DATE: 10/6/2023
PAGE: 2 OF 2
DEPARTMENT OF NATURAL RESOURCES DIVISION OF MINING, LAND & WATER 550 WEST 7TH AVE., SUITE 650 ANCHORAGE ALASKA 99501 (907) 263-6227