

STATE	PROJECT	SHEET NO.	TOTAL SHEETS
ALASKA	FH-016-1(1)	1	14

# STATE OF ALASKA DEPARTMENT OF HIGHWAYS

## PLAN AND PROFILE PROPOSED HIGHWAY PROJECT

### FH-016-1(1)

### WRANGELL SOUTH GRADING & DRAINAGE


INDEX OF SHEETS

SHEET NO.	DESCRIPTION
1	TITLE SHEET
2	TYPICAL SECTION
3	ESTIMATE OF QUANTITIES
4 & 5	SUMMARY TABLES
6 - 14	PLAN & PROFILE SHEETS

The following Standard Drawings apply to this project: A-1, C-00.01, C-10.00, D-02.01, G-04.13, G-04.31, G-10.11, I-40.10, I-80.00, M-05.00, S-00.10, S-05.00, S-20.00, T-02.00.

### AS BUILT PLANS

Contractor: Ritchie-Wayne J.V.  
Project Engineer: F.R. Speer (HEA III)  
Begin Work: July 22, 1975  
Completion Work: August 7, 1976

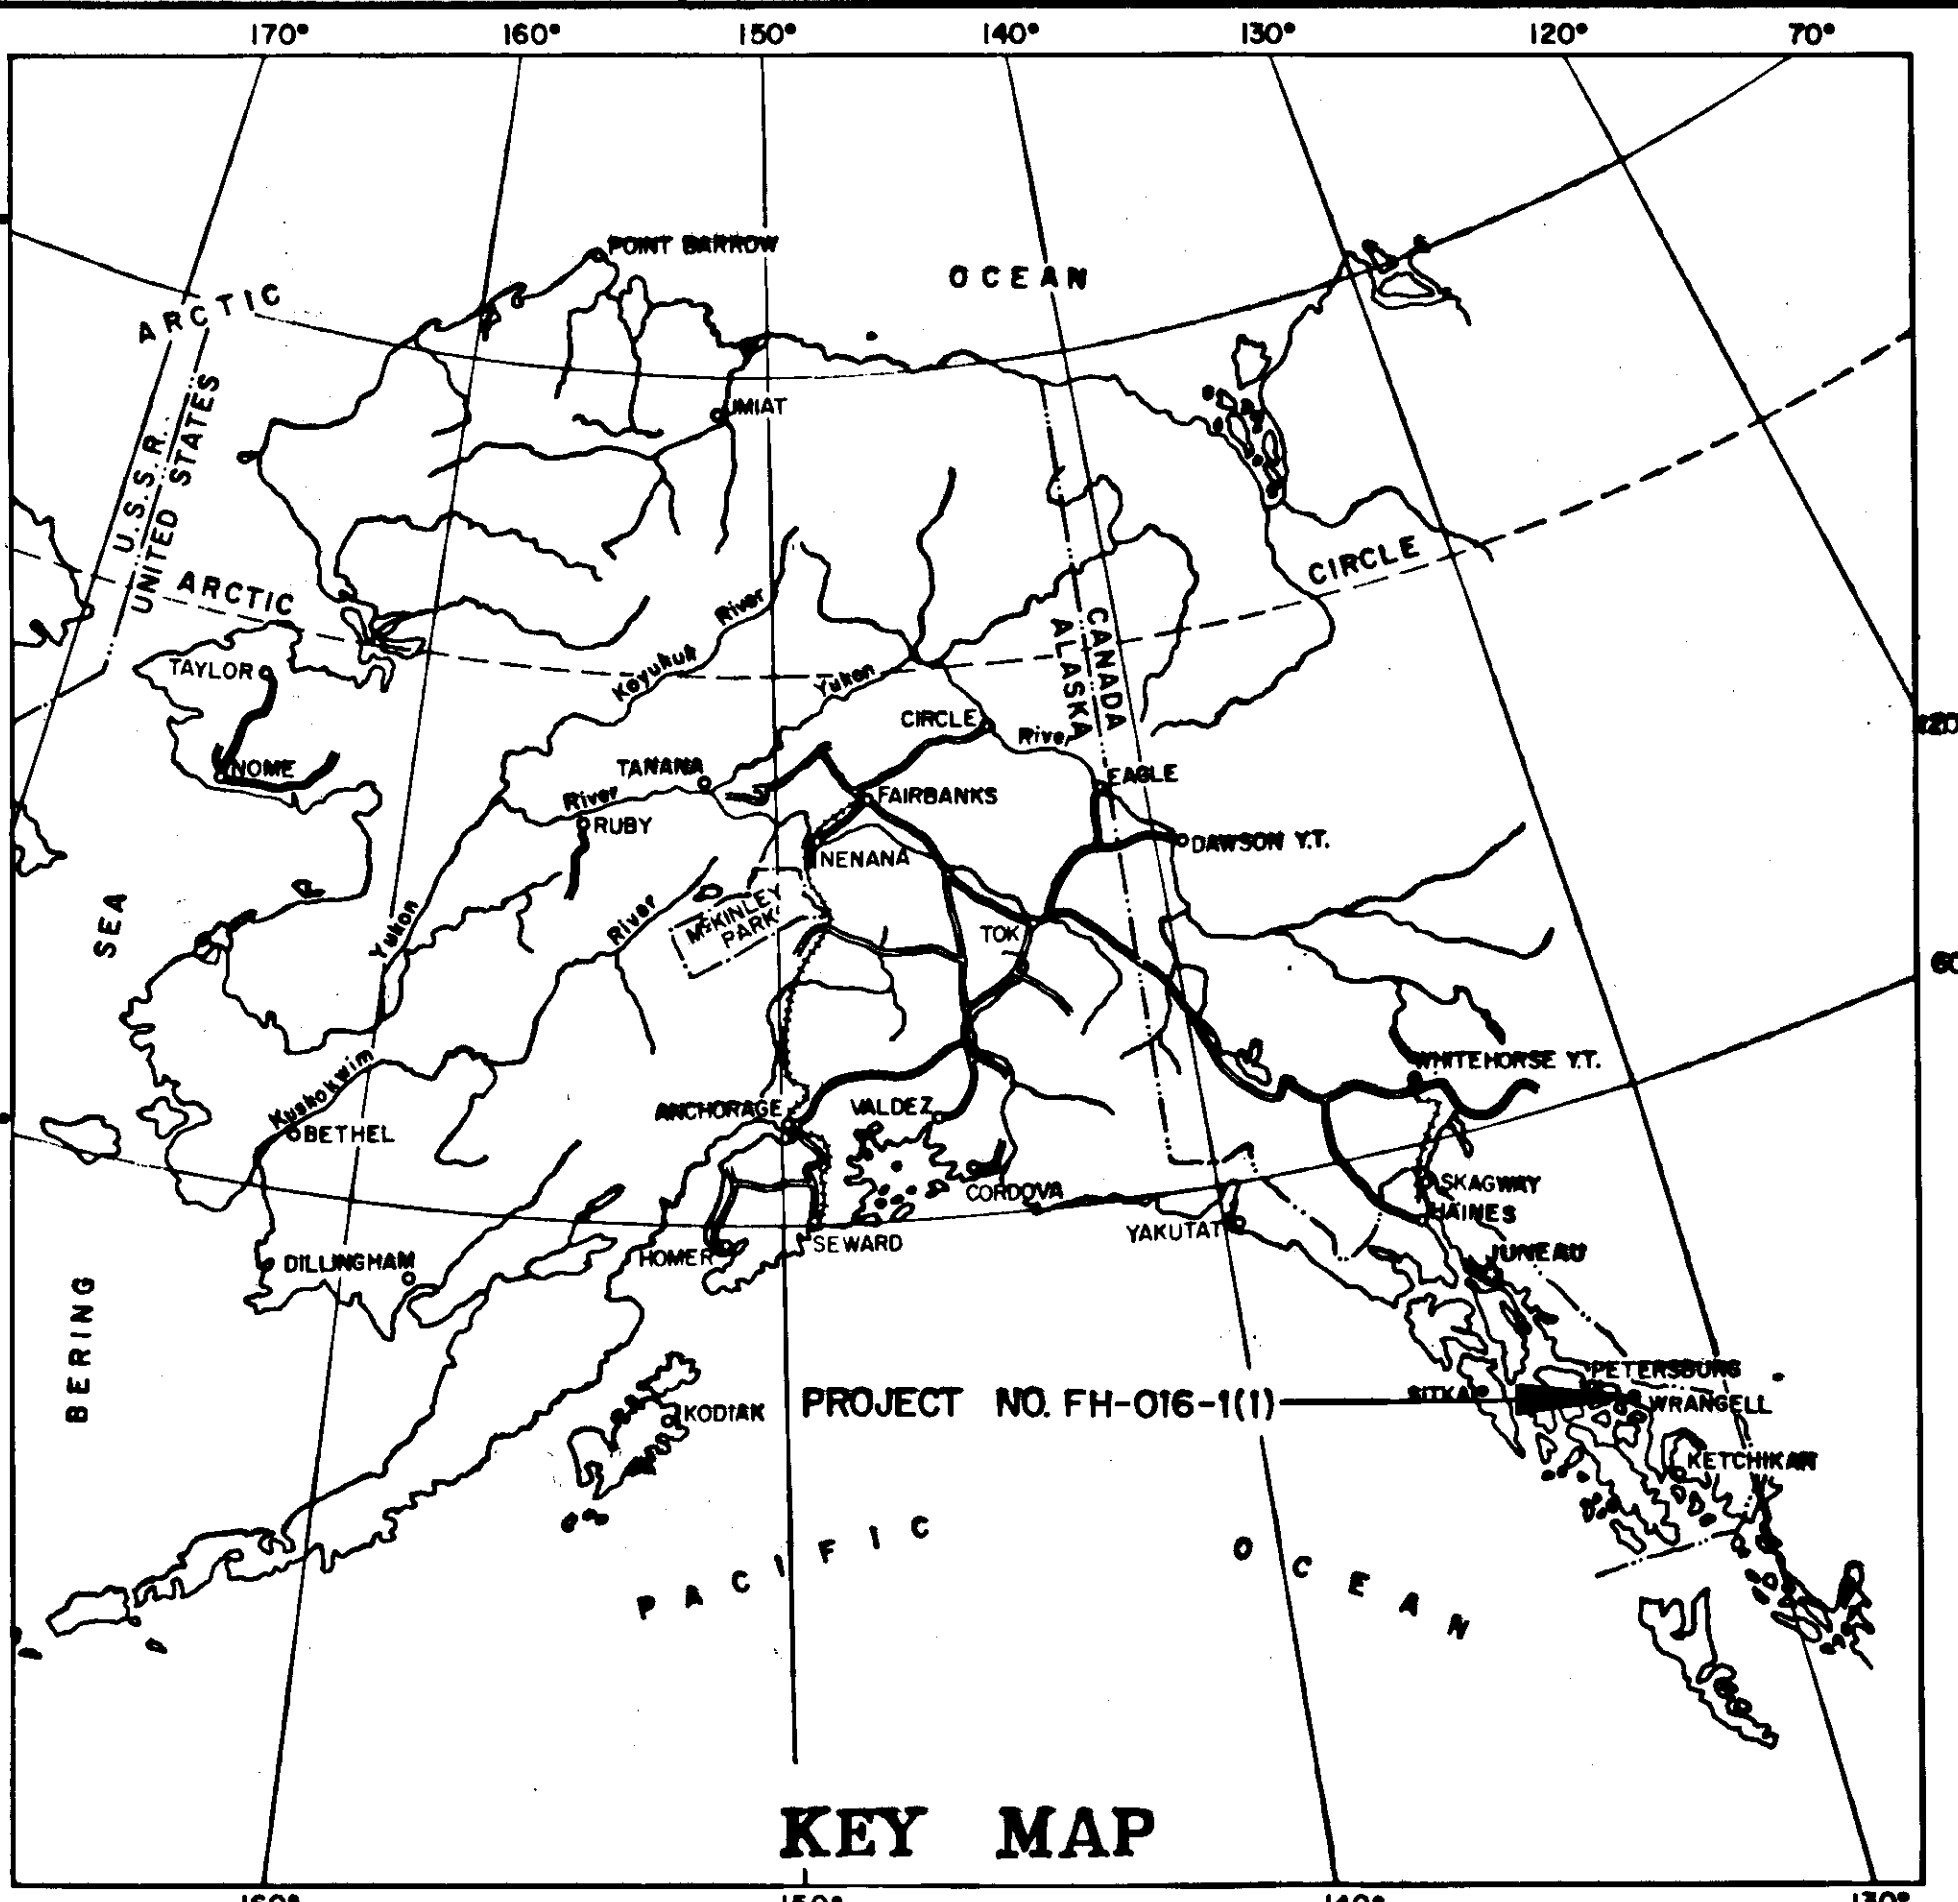


KEY MAP

**DESIGN DESIGNATION**

ADT (1974) = 210  
ADT (1995) = 660  
DHV (20%) = 130  
D = 35-65  
T = 5%

**PROJECT SUMMARY**

Width of Subgrade = 24'  
Length of Grading = 22,604.14' = 4.281 Mi.  
Length of Project = 22,604.14' = 4.281 Mi.

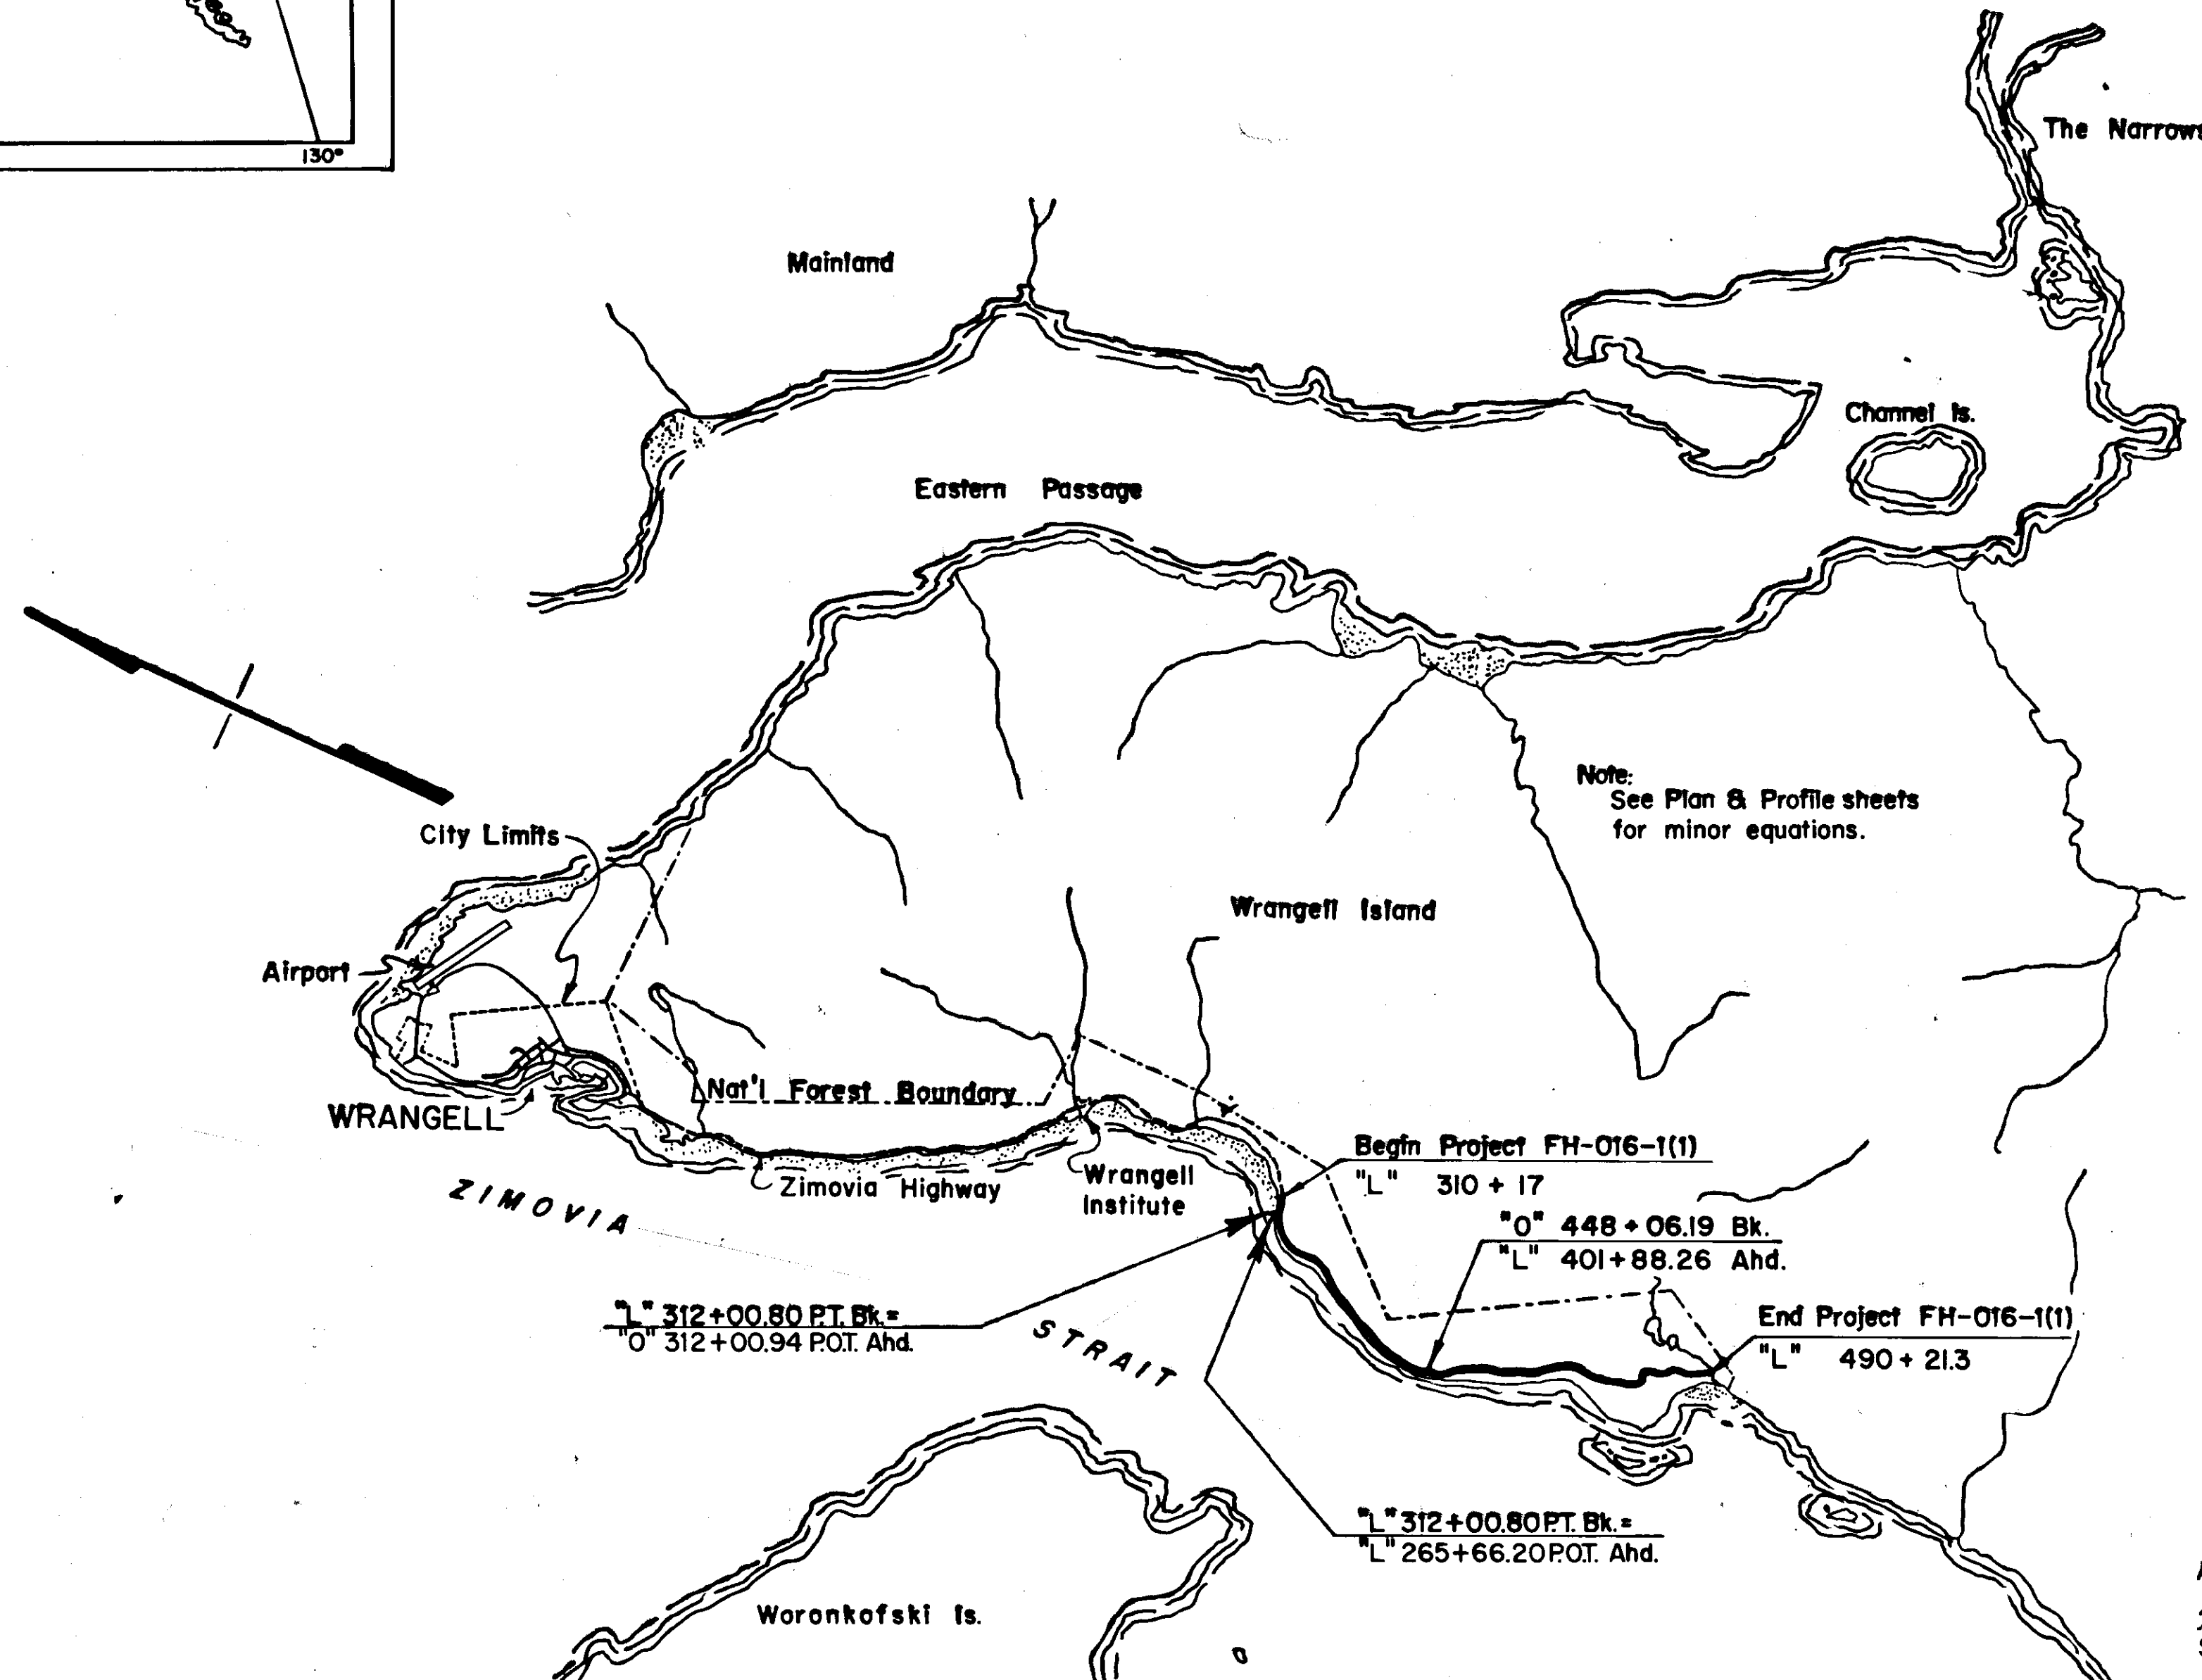


STATE OF ALASKA  
DEPARTMENT OF HIGHWAYS  
APPROVED  
*Harrison J. Will*  
SOUTHEASTERN DISTRICT ENGINEER


STATE OF ALASKA  
DEPARTMENT OF HIGHWAYS  
APPROVED  
*[Signature]*  
for COMMISSIONER OF HIGHWAYS

Date 4/20/75 Date 5-1-75

CULVERT INLET DETAIL

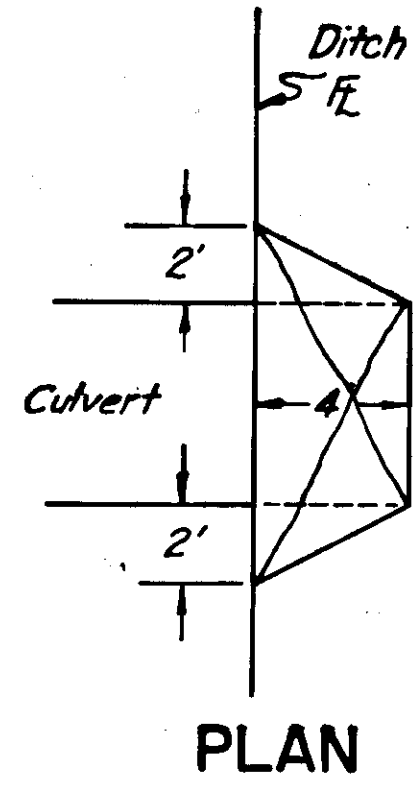

PLAN

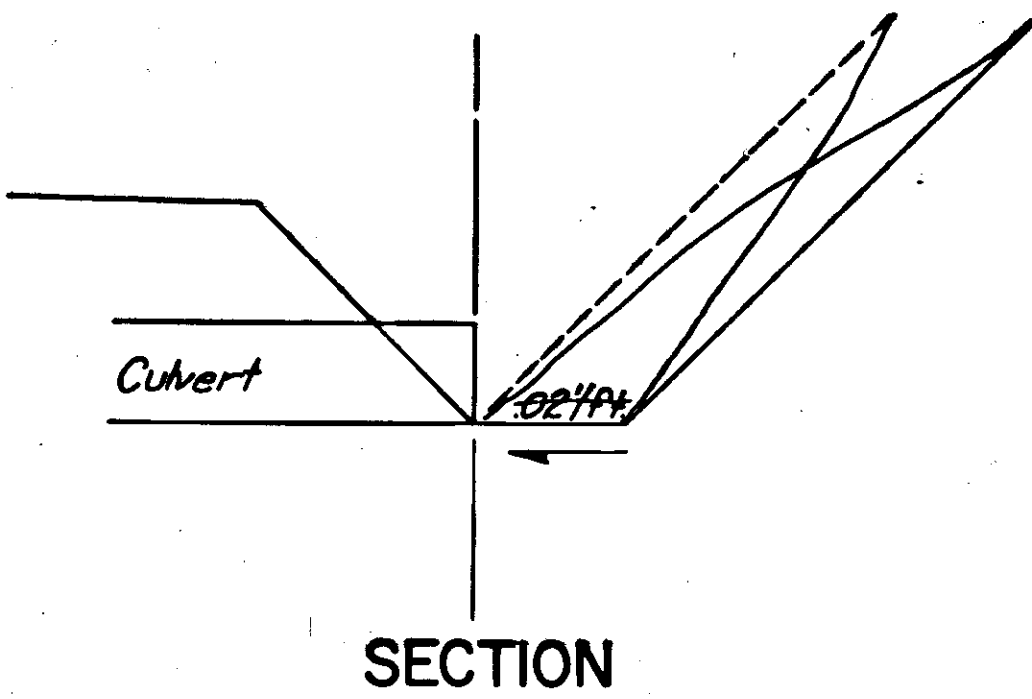


SECTION

Material	Slope
Rock	0.25:1
Other	1:1

Height of Fill	Slope
0' to 5'	3:1
5' to 10'	2.5:1
10' to 15'	2:1
15' & over	1.5:1

Note: Cut & Fill tables are a guide only, slopes may be varied to meet field conditions.

TYPICAL SECTION OF IMPROVEMENT

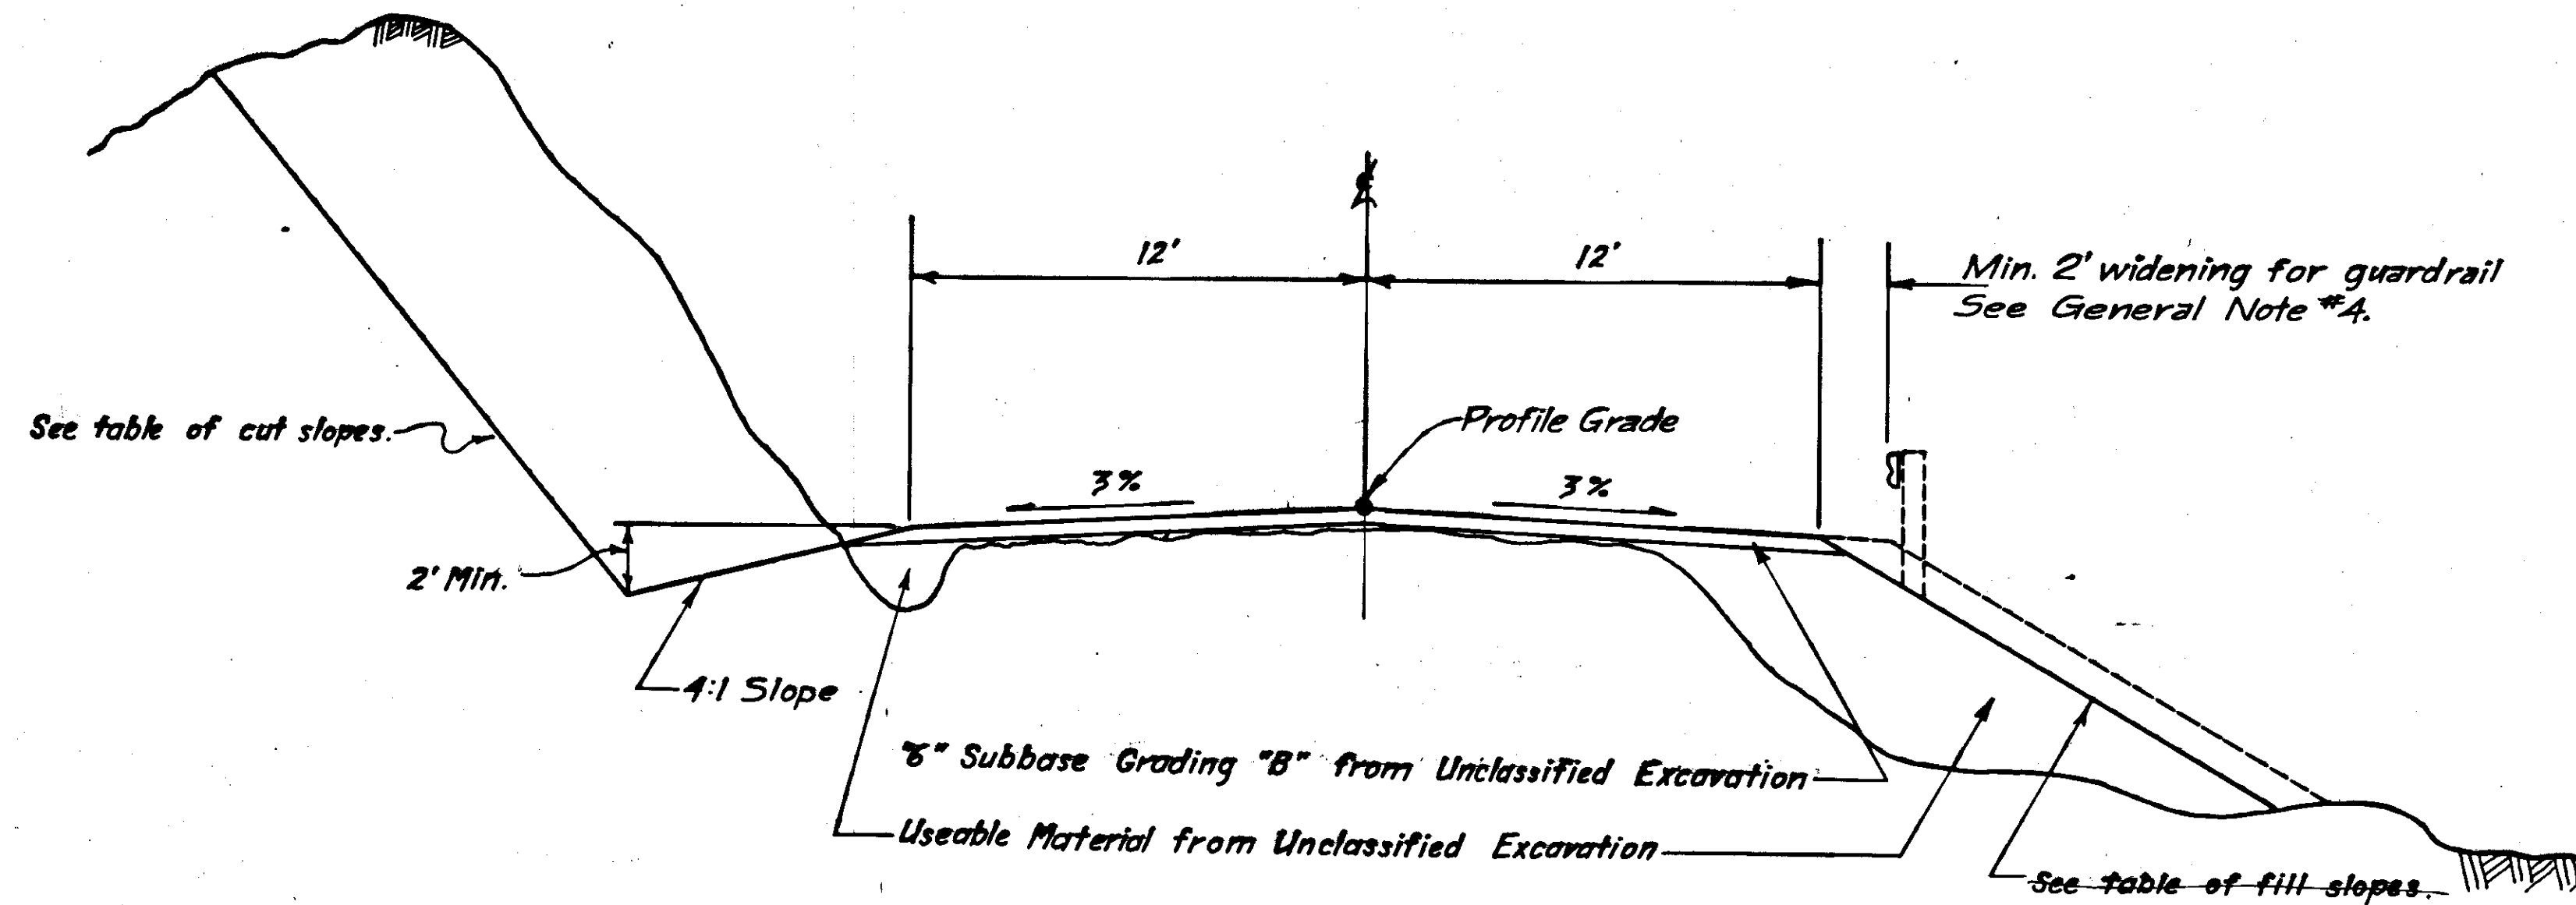

Sta. "L" 310+17 to Sta. "L" 490+21.3

STATE	PROJECT DESIGNATION	YEAR	SHEET NO.	TOTAL SHEETS
ALASKA	FH-016-1(1)	1975	2	14

GENERAL NOTES

1. Grade and alignment shown on the plans are subject to minor revisions.
2. The clearing and grubbing limits shall be a neat line five feet (5) beyond the slope limits, or to the R.O.W. limits whichever is less.
3. Super elevation shall be revolved about the inside shoulder, or as staked by the engineer. See Standard Drawing I-80.00, Case II.
4. Where practicable the guardrail shall be installed along the existing shoulder or the new shoulder whichever is further to the right as staked by the Engineer.
5. The contractor shall be allowed to use steel or wood guardrail posts. See Standard Drawing G-04.13 and G-04.31.
6. Existing utility poles that fall within the roadway prism shall be moved by others.
7. Approach radii shall be as staked by the engineer.
8. The design height of fill does not exceed the cover requirements for minimum gages of pipe conduit.
9. 0+445+29 to E.O.P. Processing for subgrade modification, Item 302(3), will include shaping the roadway to the typical section as staked by the engineer.
10. 0+445+29 to E.O.P. The heavy centerline shown on the plans is the control line. The existing road is to be improved. Pay Item 302(3) will be measured along the finished roadway centerline.



# CULVERT SUMMARY

Station	INSTALL						Remarks
	6" Pipe Conduit	18" Pipe Conduit	24" Pipe Conduit	30" Pipe Conduit	36" Pipe Conduit		
"L" 311+74			40				
"O" 313+71			46				
"O" 315+82			46				
"O" 318+72			46				
"O" 320+50			42				
"O" 324+26			42				
"O" 327+90			46				
"O" 332+07			42				
"O" 333+28			46				
"O" 335+17			46				
"O" 336+33			42				Deleted
"O" 337+52			48				
"O" 340+70			40				Deleted
"O" 342+82			40				
"O" 344+68			40				
"O" 345+52			44				Construct Ditch Block
"O" 348+89			40				Remove 5' X 5' Wood Culvert
"O" 349+41	38		40				Conduit for Water Service
"O" 349+04	20	20					Approach Culvert No Culvert at this Approach.
"O" 350+95			40				
"O" 352+35			40				
"O" 353+26			40				
"O" 353+99	44						Conduit for Water Service
"O" 354+73			46				Construct Ditch Block
"O" 355+52			40				Deleted
"O" 357+82			40				Needed New installation
"O" 359+58			42				
"O" 360+43			52				
"O" 361+77			44				Construct Ditch Block
"O" 362+92			44				Construct Ditch Block
"O" 364+25			44				Construct Ditch Block
"O" 365+84			42				Construct Ditch Block
"O" 366+64			44				Construct Ditch Block
"O" 369+66			40				Construct Ditch Block
"O" 369+89			44				
"O" 371+34			48				
"O" 372+20			42				
"O" 376+05			42				
"O" 378+13			42				
"O" 379+57			52				
"O" 381+22			48				
"O" 381+89			42				
"O" 383+72			42				
"O" 384+54			42				
"O" 385+38			42				
"O" 387+23			46				
"O" 388+69			42				

Station	INSTALL					Remarks
	18" Pipe Conduit	24" Pipe Conduit	36" Pipe Conduit	48" Pipe Conduit		
"O" 391+11	26		40			
"O" 392+48	28		42			
"O" 394+17	20		42			unable to locate remaining 8" in field.
"O" 396+54	30		40			Needed New installation.
"O" 398+24	38		40			Deleted
"O" 401+12	40		46			Not on Plans & Located in field
"O" 403+81	30		40			No New installation
"O" 405+30	27		42			
"O" 406+48	26		40			
"O" 407+76	27		40			
"O" 402+95	36		42			Extg. Not on Plans & Located in field.
"O" 408+58	28		40			& New installation installed
"O" 410+40	28		42			
"O" 411+12	29		40			
"O" 412+19	28		40			
"O" 412+87	26		42			
"O" 414+77	27		40			
"O" 417+62	27		40			
"O" 418+52	27		40			
"O" 419+74	30		40			
"O" 421+37	31		44			
"O" 423+77	44		52			
"O" 425+38	27		40			
"O" 425+98	20	20				Approach Culvert
"O" 425+93	28		40			new installation Deleted
"O" 427+41	28		40			
"O" 428+99	25		40			
"O" 430+11	28		40			
"O" 430+62	28		40			
"O" 431+84	28		40			
"O" 433+07	29		38			
"O" 434+75	48		60			
"O" 435+42	35		46			
"O" 436+07	32		42			
"O" 436+82	33		44			
"O" 437+62	37		40			
"O" 438+61			40			100' error in location on plans
"O" 440+13	34		40			
"O" 440+18	20	20				Approach Culvert
"O" 442+04	51		56			Construct Ditch Block
"O" 444+31	41		50			Construct Ditch Block
"O" 446+12	42	42				Construct Ditch Block
"L" 403+40	35		40			Construct Ditch Block
"L" 406+40	34		42			Construct Ditch Block
"L" 413+15	42	42				
"L" 414+30	32	40				
"L" 415+58	35	40				Remaining 13' of extg. impractical to excavate

Station	INSTALL				Remarks
	18" Pipe Conduit	24" Pipe Conduit	36" Pipe Conduit	48" Pipe Conduit	
"L" 418+42	30	44			Remaining 10' of extg. impractical to excavate
"L" 420+40	28	40			
"L" 424+25	30	40			
"L" 425+12				8	Extend
"L" 427+85	34	40			
"L" 429+85	45	46			
"L" 430+90	40	40			
"L" 433+35	28	40			
"L" 435+40	28	40			Unable to locate extg. in field.
"L" 437+30	28	38			
"L" 440+12	50	46			
"L" 442+40	43	44			
"L" 443+65	34	40			
"L" 446+03	32	40			Unable to locate extg. in field.
"L" 447+98	34	42			
"L" 449+50	30	40			
"L" 452+15	45	46			
"L" 456+80	37	40			Construct Ditch Block
"L" 458+25	47	48			Construct Ditch Block
"L" 459+30	43	44			Construct Ditch Block
"L" 460+33	44	44			Construct Ditch Block
"L" 462+20	42	42			Construct Ditch Block
"L" 463+55	40	44			Construct Ditch Block
"L" 465+15	40	44			Construct Ditch Block
"L" 467+10	40	40			Construct Ditch Block
"L" 469+10	45	44			Construct Ditch Block
"L" 471+93	44	42			Construct Ditch Block
"L" 473+50	46	44			Construct Ditch Block
"L" 477+52	42	42			Construct Ditch Block
"L" 480+18	49	46			Construct Ditch Block
"L" 482+90	40	42			Construct Ditch Block
"L" 488+45	40	42			Construct Ditch Block
6" Additional Culverts					
"O" 423+90	40				
"O" 427+45	40				
"O" 438+68	40				
"O" 444+16	40				
E.W.O.#4					
"O" 348+89	installed 72" x 44" x 48' Arch Pipe.				

### APPROACH SUMMARY

STATION	Left	Right
"0" 349+08	X	
"0" 349+62		X
"0" 350+45	X	X
"0" 351+83	X	
"0" 351+30		X
"0" 352+97	X	
"0" 401+30		X
"0" 403+50		X
"0" 425+78	X	X
"0" 434+20	X	X
"0" 434+92	X	
"0" 436+45	X	
"0" 426+12		X
"0" 439+21		X
"0" 440+35	X	
"0" 443+70		X
"0" 443+19	X	
"L" 479+30	X	X
"L" 482+20	X	
"L" 489+80	X	

No Approach

No Approach

No Approach

### SIGNING SCHEDULE

No.	STATION	Dist. from		Code Number	Legend	Sign Panel Thickness			Sq. Ft.	No. of Post	Post			Facing Traffic	Remarks	
		Lt.	Rt.			Size	Unframed	Framed			Type	Size	Length			Embedment
1	"L" 423+25.5		16	W1-2R	Curve Right	30" x 30"	0.063"		6.25	1	Tube	2"	8' 6"	4' 6"	SB	
2	"L" 432+25.1	16		W1-2L	Curve Left	30" x 30"	0.063"		6.25	1	Tube	2"	8' 6"	4' 6"	NB	
3	"L" 444+51.6		16	W1-5L	Winding Road	30" x 30"	0.063"		6.25	1	Tube	2"	8' 6"	4' 6"	SB	
4	"L" 479+20	20	20	R 1-1	Stop	30" x 30"	0.063"		6.25	1	Tube	2"	8' 0"	4' 6"	WB	
5	"L" 479+75	20	20	R 1-1	Stop	30" x 30"	0.063"		6.25	1	Tube	2"	8' 0"	4' 6"	EB	
6	"L" 480+21.9	20	16	W14-4	End Road 1000 ft.	30" x 30"	0.063"		6.25	1	Tube	2"	8' 6"	4' 6"	SB	Deleted C.O.#5
7	"L" 480+30	20		R 1-2	Yield	30" x 30"	0.063"		2.70	1	Tube	2"	8' 0"	4' 6"	WB	
8	"L" 480+60	20		R 5-1	Do Not Enter	30" x 30"	0.063"		6.25	1	Tube	2"	8' 0"	4' 6"	EB	
9	"L" 490+21.3			W14-3	End	30" x 30"	0.063"		6.25	1	Tube	2"	10' 0"	4' 6"	SB	With Type 1 Object Marker Deleted C.O.#5


#### GENERAL SIGNING NOTES:

1. Sign locations are approximate only and shall be located by the Engineer.
2. All sign posts shall be telescoping perforated, galvanized steel post, 12 ga.. The 2" size shall be used above ground, and the 2 1/2" size shall be used below ground.

### GUARDRAIL SUMMARY

From STATION	To STATION	Lt.	Rt.	Remarks
"L" 310+17	"0" 339+17		Rt.	See General Note #4
"0" 353+38	"0" 400+91.43		Rt.	See General Note #4
"L" 406+50	"L" 416+50		Rt.	"L" 405+75 - "L" 409+50
"L" 433+50	"L" 437+50		Rt.	"L" 412+00 - "L" 416+75
"L" 445+50	"L" 452+50		Rt.	"L" 417+75 - "L" 421+00
"L" 457+50	"L" 459+50		Rt.	"L" 424+00 - "L" 426+50
"L" 471+50	"L" 473+50		Rt.	"L" 432+00 - "L" 437+75
"L" 487+50	"L" 489+50		Rt.	"L" 445+50 - "L" 452+50

STATE	PROJECT DESIGNATION	YEAR	SHEET NO.	TOTAL SHEETS
ALASKA	FH-016-1(1)	1975	6	14

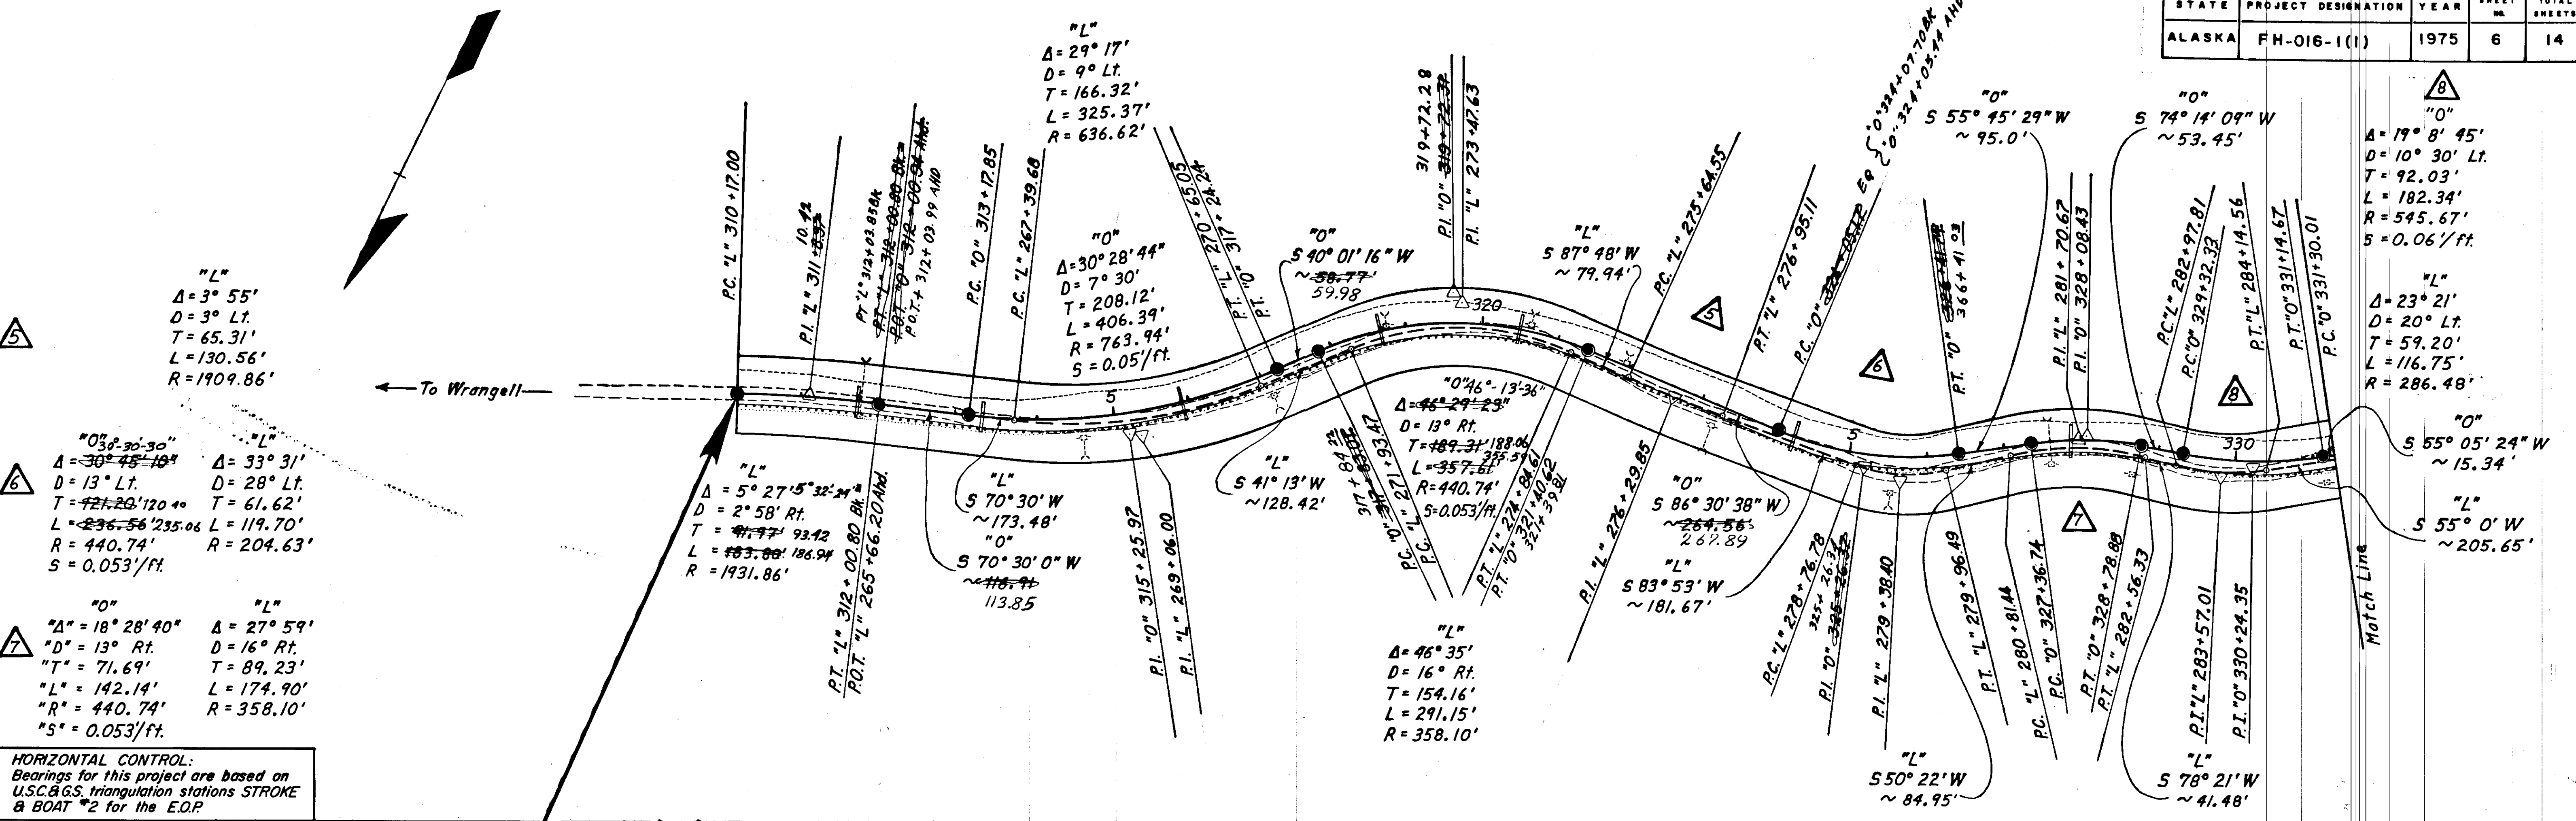

"L"  
 $\Delta = 3^\circ 55'$   
 $D = 3^\circ \text{ Lt.}$   
 $T = 65.31'$   
 $L = 130.56'$   
 $R = 1909.86'$

"O"  
 $\Delta = 18^\circ 28' 40''$   
 $D = 13^\circ \text{ Rt.}$   
 $T = 71.69'$   
 $L = 142.14'$   
 $R = 440.74'$   
 $S = 0.053/\text{ft.}$

"L"  
 $\Delta = 33^\circ 31'$   
 $D = 28^\circ \text{ Lt.}$   
 $T = 61.62'$   
 $L = 119.70'$   
 $R = 204.63'$

"O"  
 $\Delta = 27^\circ 59'$   
 $D = 16^\circ \text{ Rt.}$   
 $T = 89.23'$   
 $L = 174.90'$   
 $R = 358.10'$   
 $S = 0.053/\text{ft.}$

**HORIZONTAL CONTROL:**  
 Bearings for this project are based on U.S.C. & G.S. triangulation stations STROKE & BOAT #2 for the E.O.P.


**VERTICAL CONTROL:**  
 The vertical control was derived from a B.P.R. B.M.-RP, a brass cap stamped "B.M.R.P.-P.O.C. 307+50", and set at Sta. "L" 307+50. Elev. 57.50

**Earthwork Equation:**  
 $\text{Embankment} = \text{Excavation} - \text{Waste} \times \text{Grading Factor}$


T.B.M. #1 Point on point of rock cut  
 "L" 279+00±, Elev. 52.80

Embankment = 858 Cu. Yd.  
 Unclassified Excavation = 2813± Cu. Yd. (Includes 800 Cu. Yd. Waste)  
 Subbase Grading "B" = 1,048 Cu. Yd. from Unclassified Excavation.

**BEGINNING OF PROJECT**  
 FH-016-1(1)  
 Sta. "L" 310+17.00

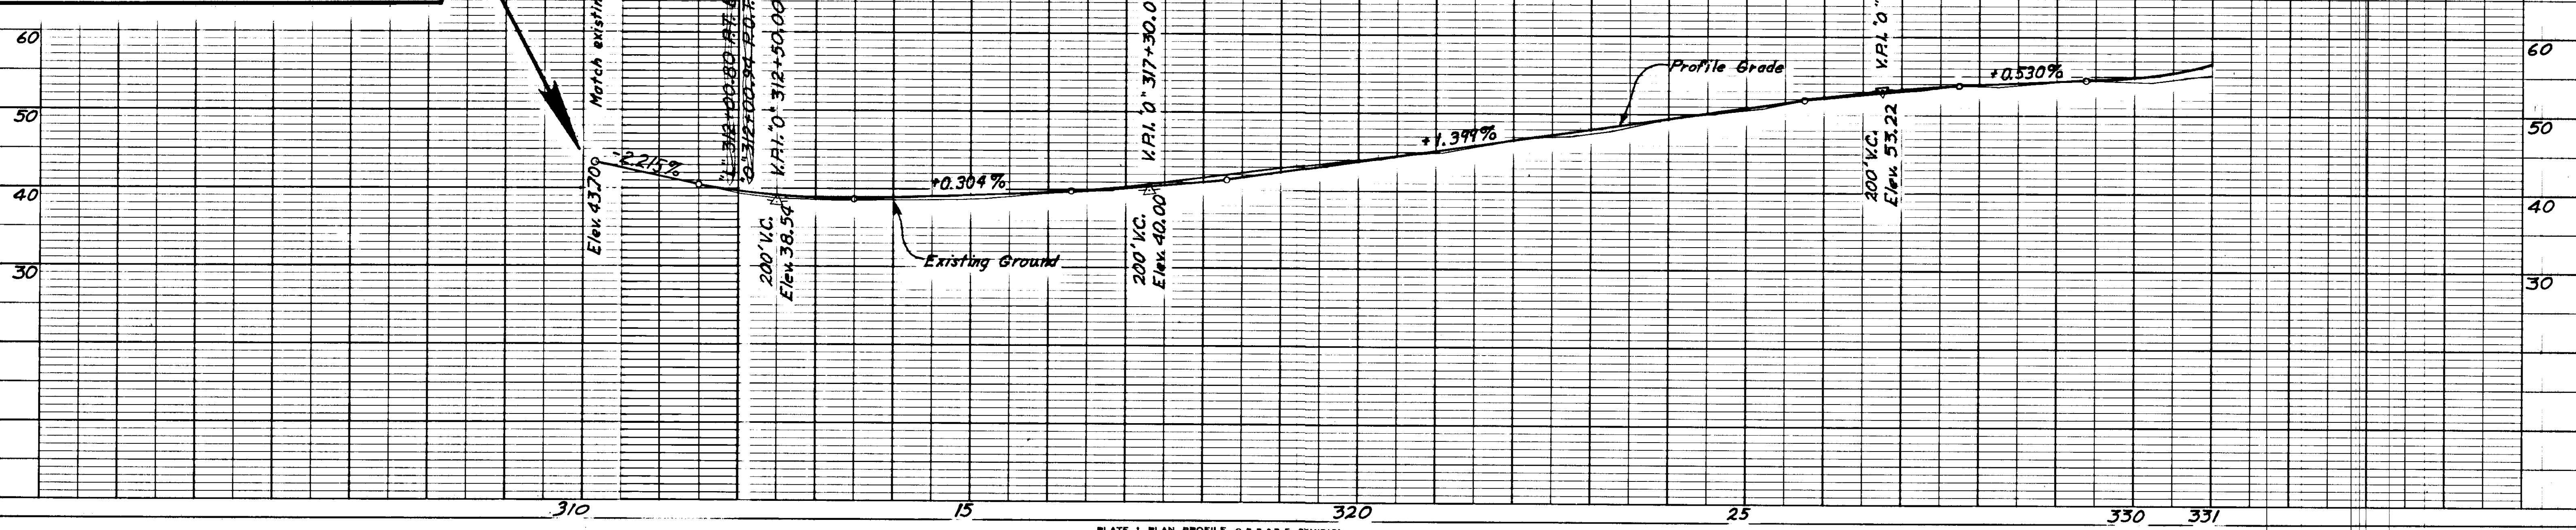


STATE	PROJECT DESIGNATION	YEAR	SHEET NO.	TOTAL SHEETS
ALASKA	FH-016-1(1)	1975	7	14

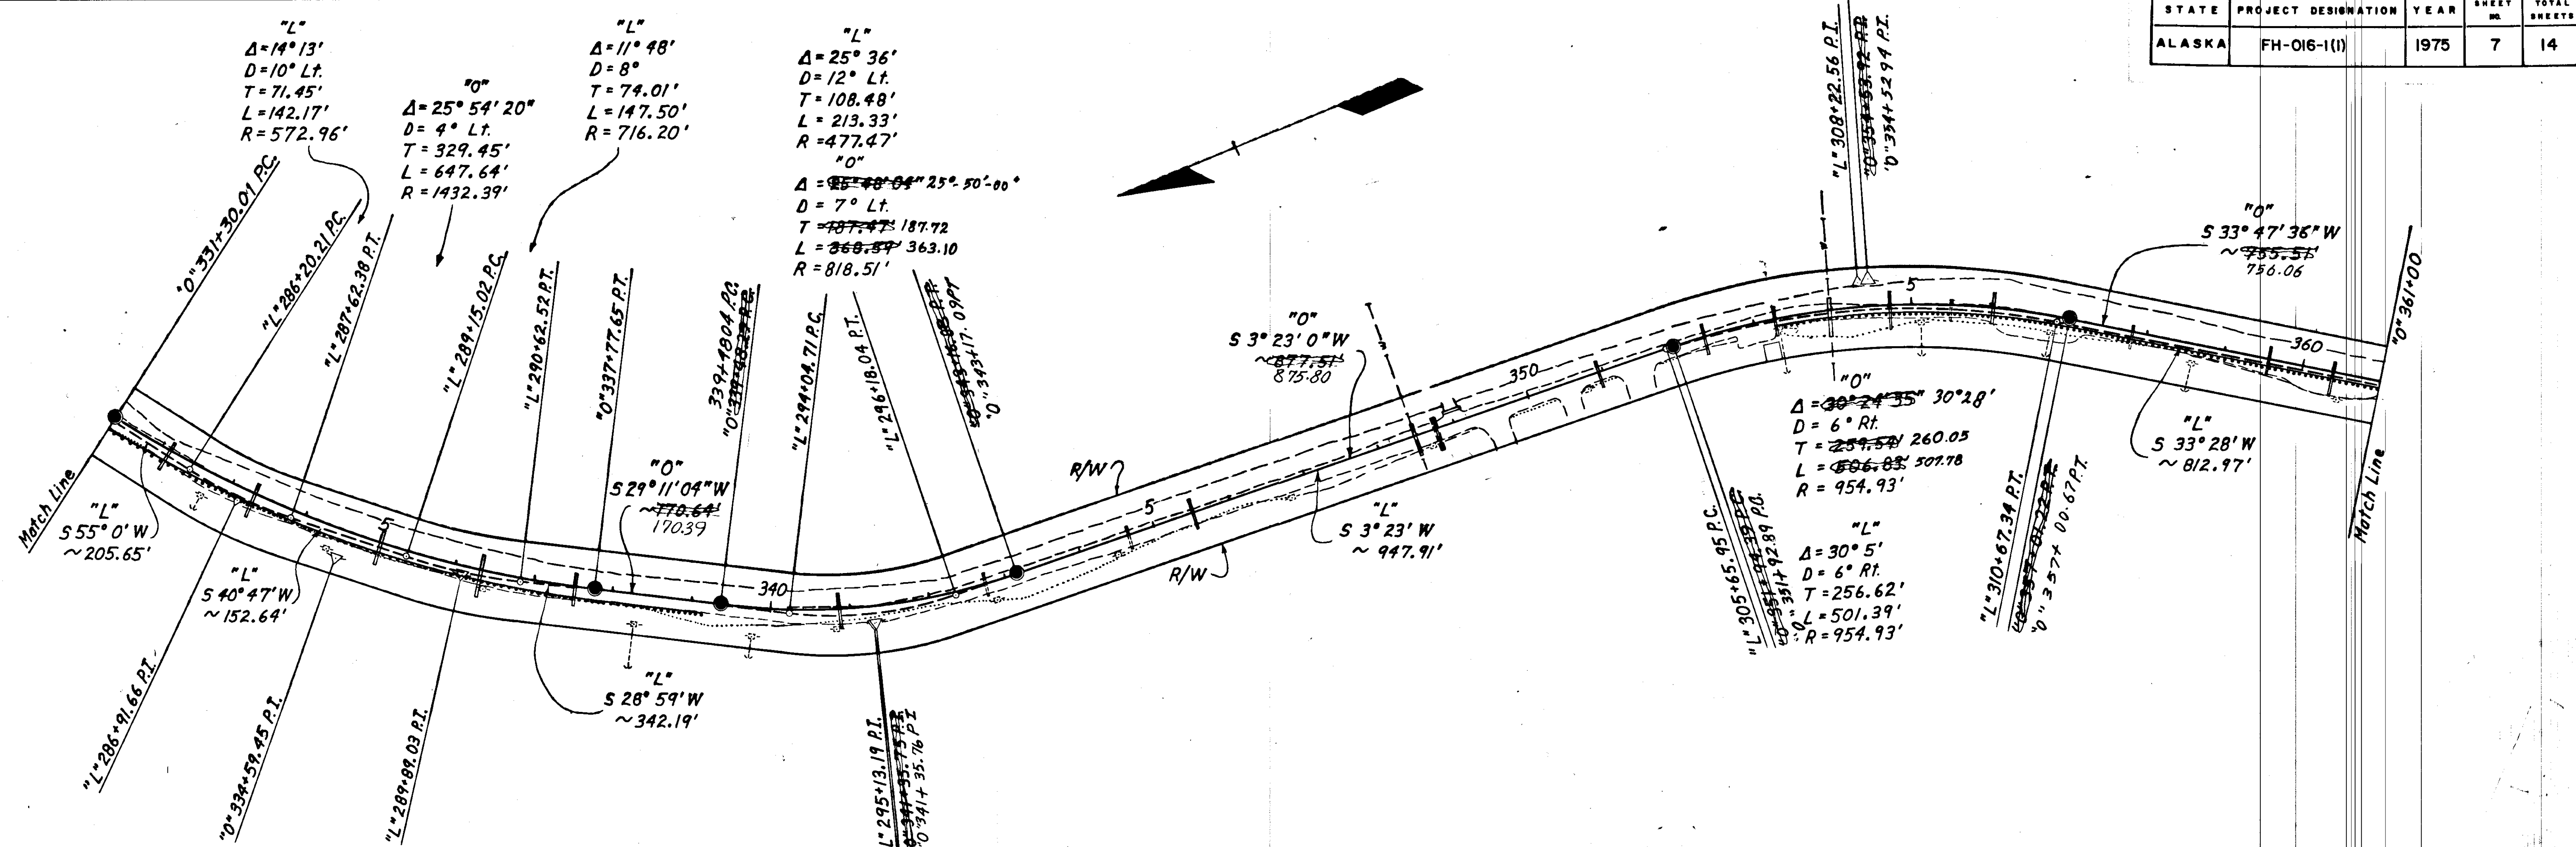


TBM #3 Spike in top of stump  
 "L" 297+70.40 RT. Elev. 84.07  
 TBM #3A Spike in 16" Spruce  
 "L" 297+70.40 RT. Elev. 81.20

TBM #4 Spike in 20" Spruce  
 "L" 304+60.40 RT. Elev. 70.83  
 TBM #4A Spike in 12" Spruce  
 "L" 304+73.40 RT. Elev. 67.92

Embankment = 1,892 Cu. Yd.  
 Unclassified Excavation = 2,346 Cu. Yd. (Includes 894 Cu. Yd. Waste)  
 Subbase Grading "B" = 1,524 Cu. Yd. from Unclassified Excavation

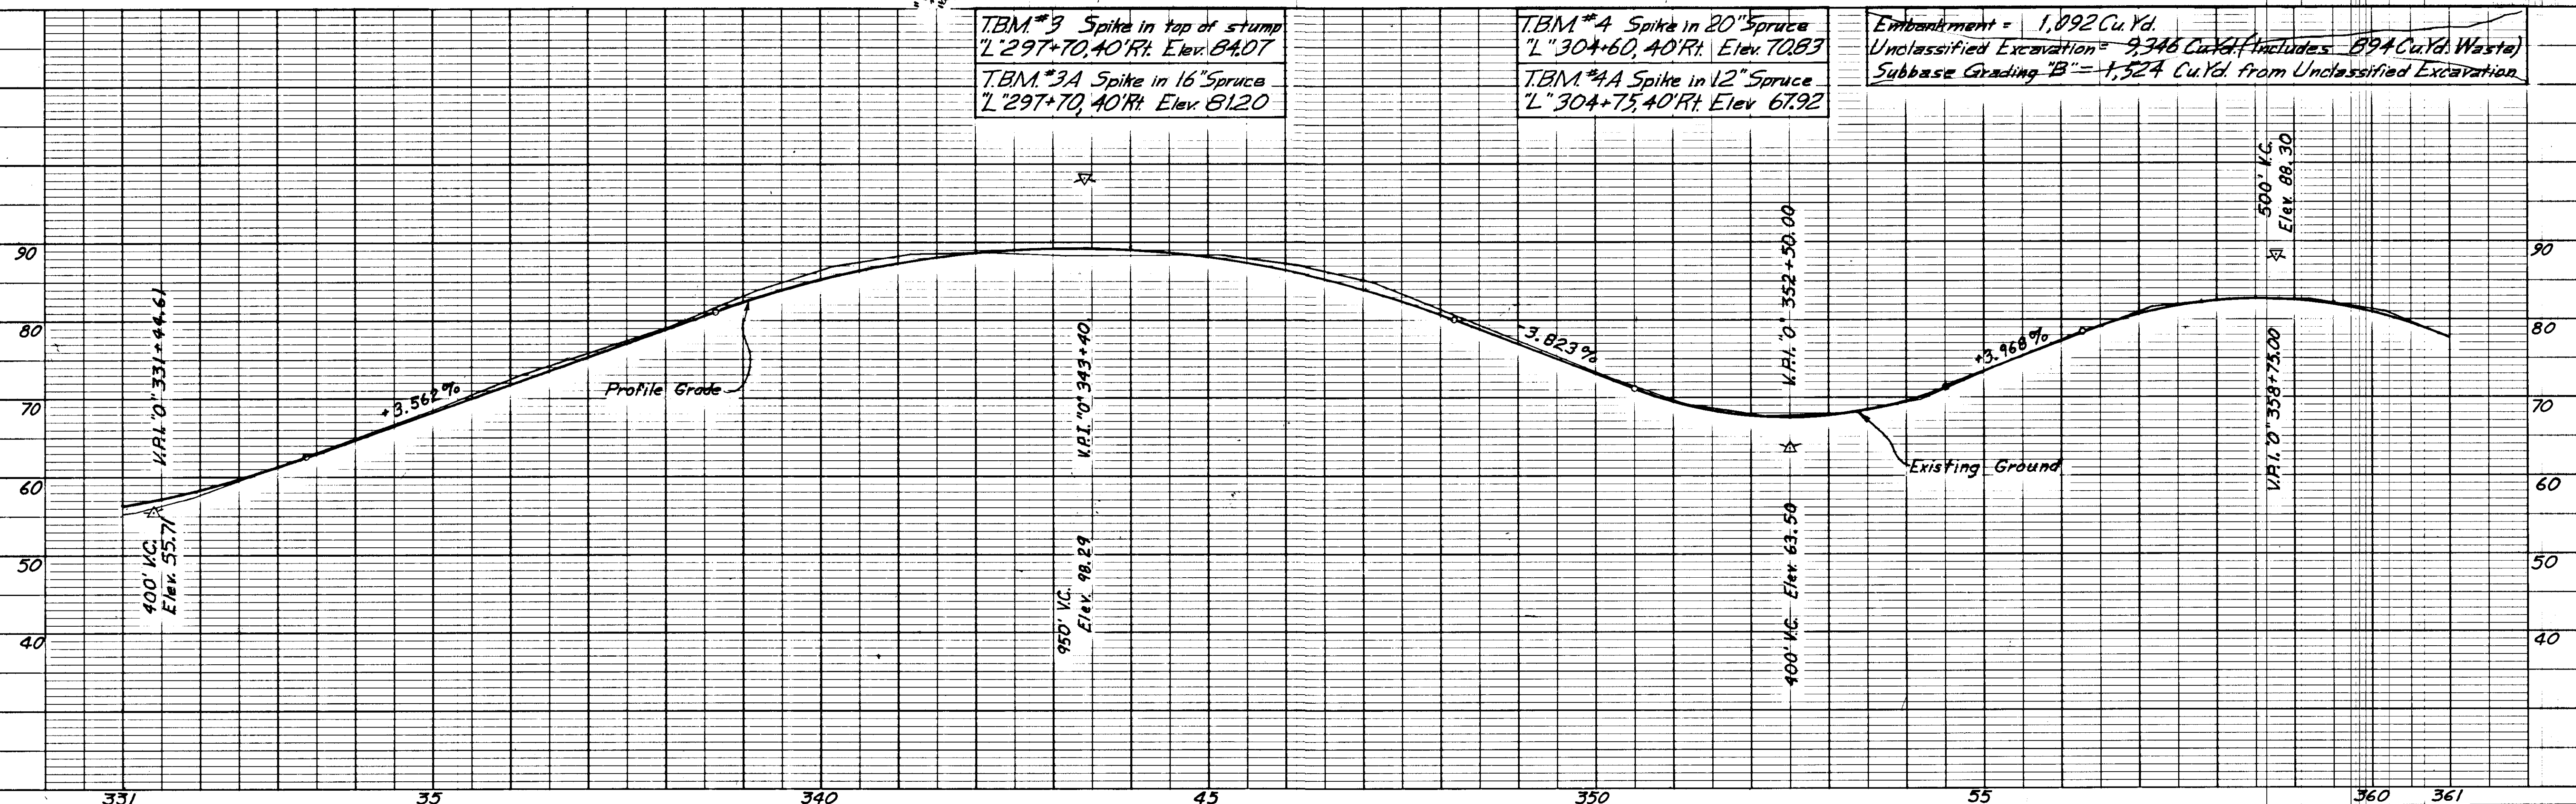

STATE	PROJECT DESIGNATION	YEAR	SHEET NO.	TOTAL SHEETS
ALASKA	FH-016-1(1)	1975	8	14

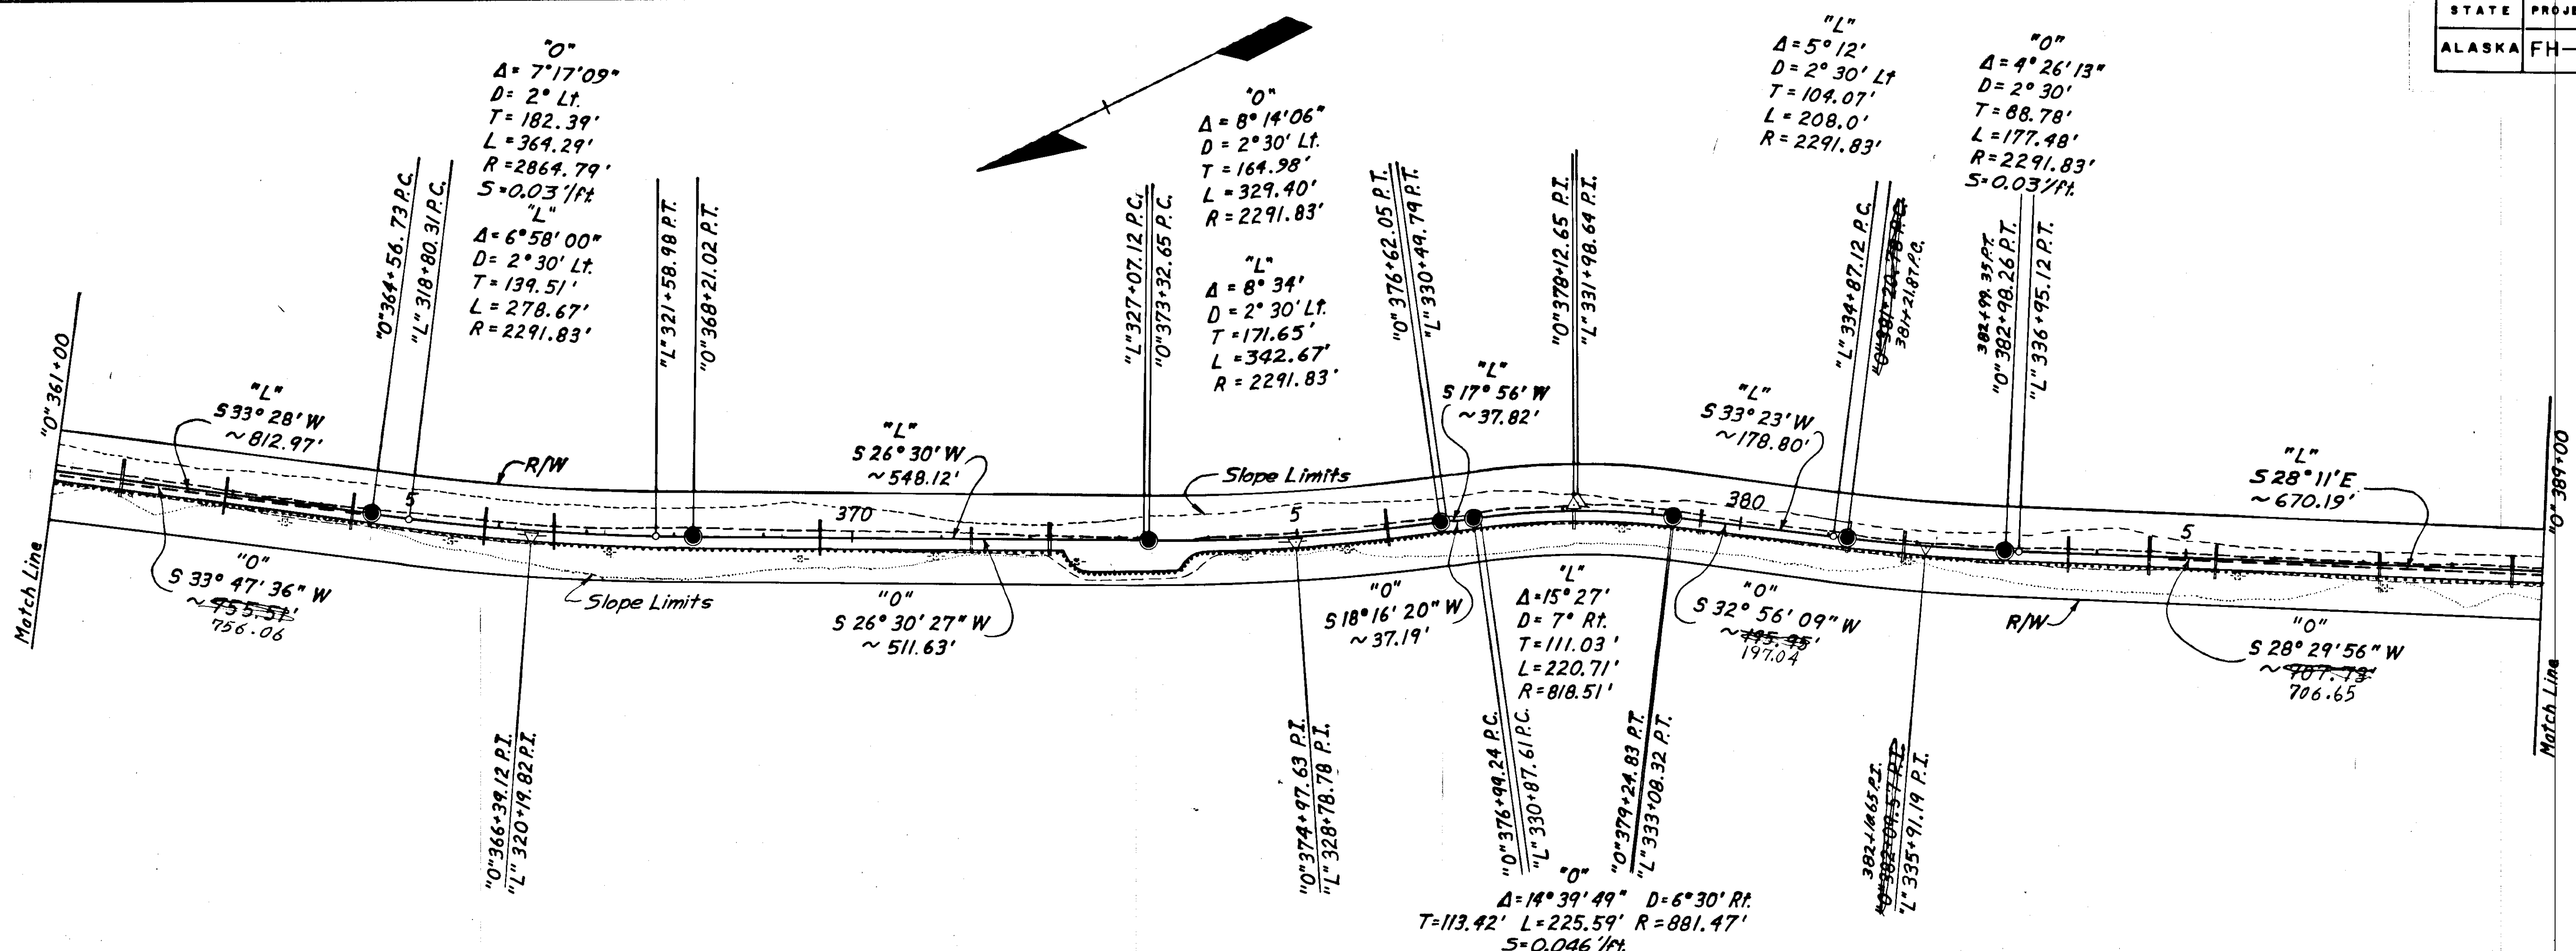


TBM #5A Spike in 26" Hemlock  
 "L" 317+18, 52' Rt, Elev. 60.87

TBM #5 Spike in 48" Spruce  
 "L" 317+47, 38' Rt, Elev. 67.85


TBM #6 Spike in 30" Spruce  
 "L" 330+20, 40' Rt, Elev. 30.07

Embankment = 5,176 Cu. Yd.  
 Unclassified Excavation = 2,603 Cu. Yd. (Includes 1,416 Cu. Yd. Waste)  
 Subbase Grading "B" = 1,446 Cu. Yd. from Unclassified Excavation

TBM #7 Painted sharp point on rock ledge  
 "L" 339+90, 16' Lt, Elev. 34.15

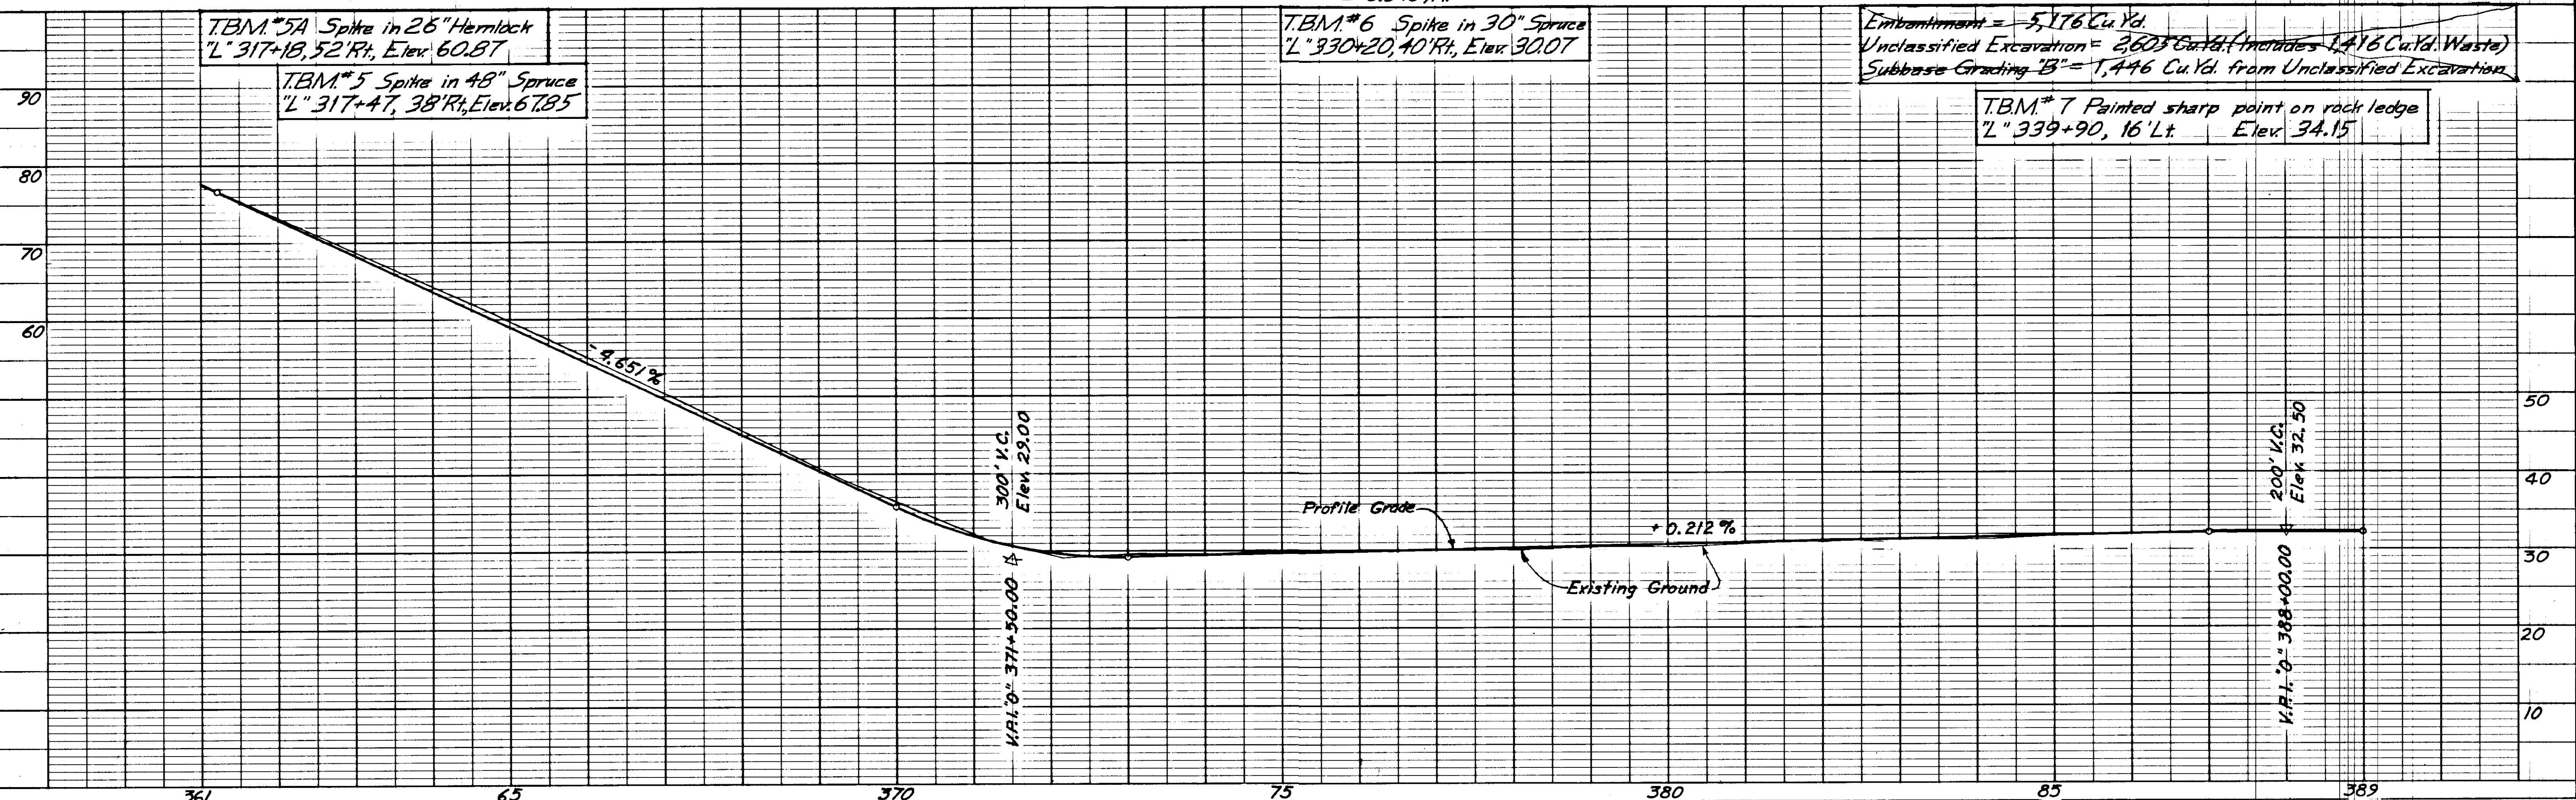



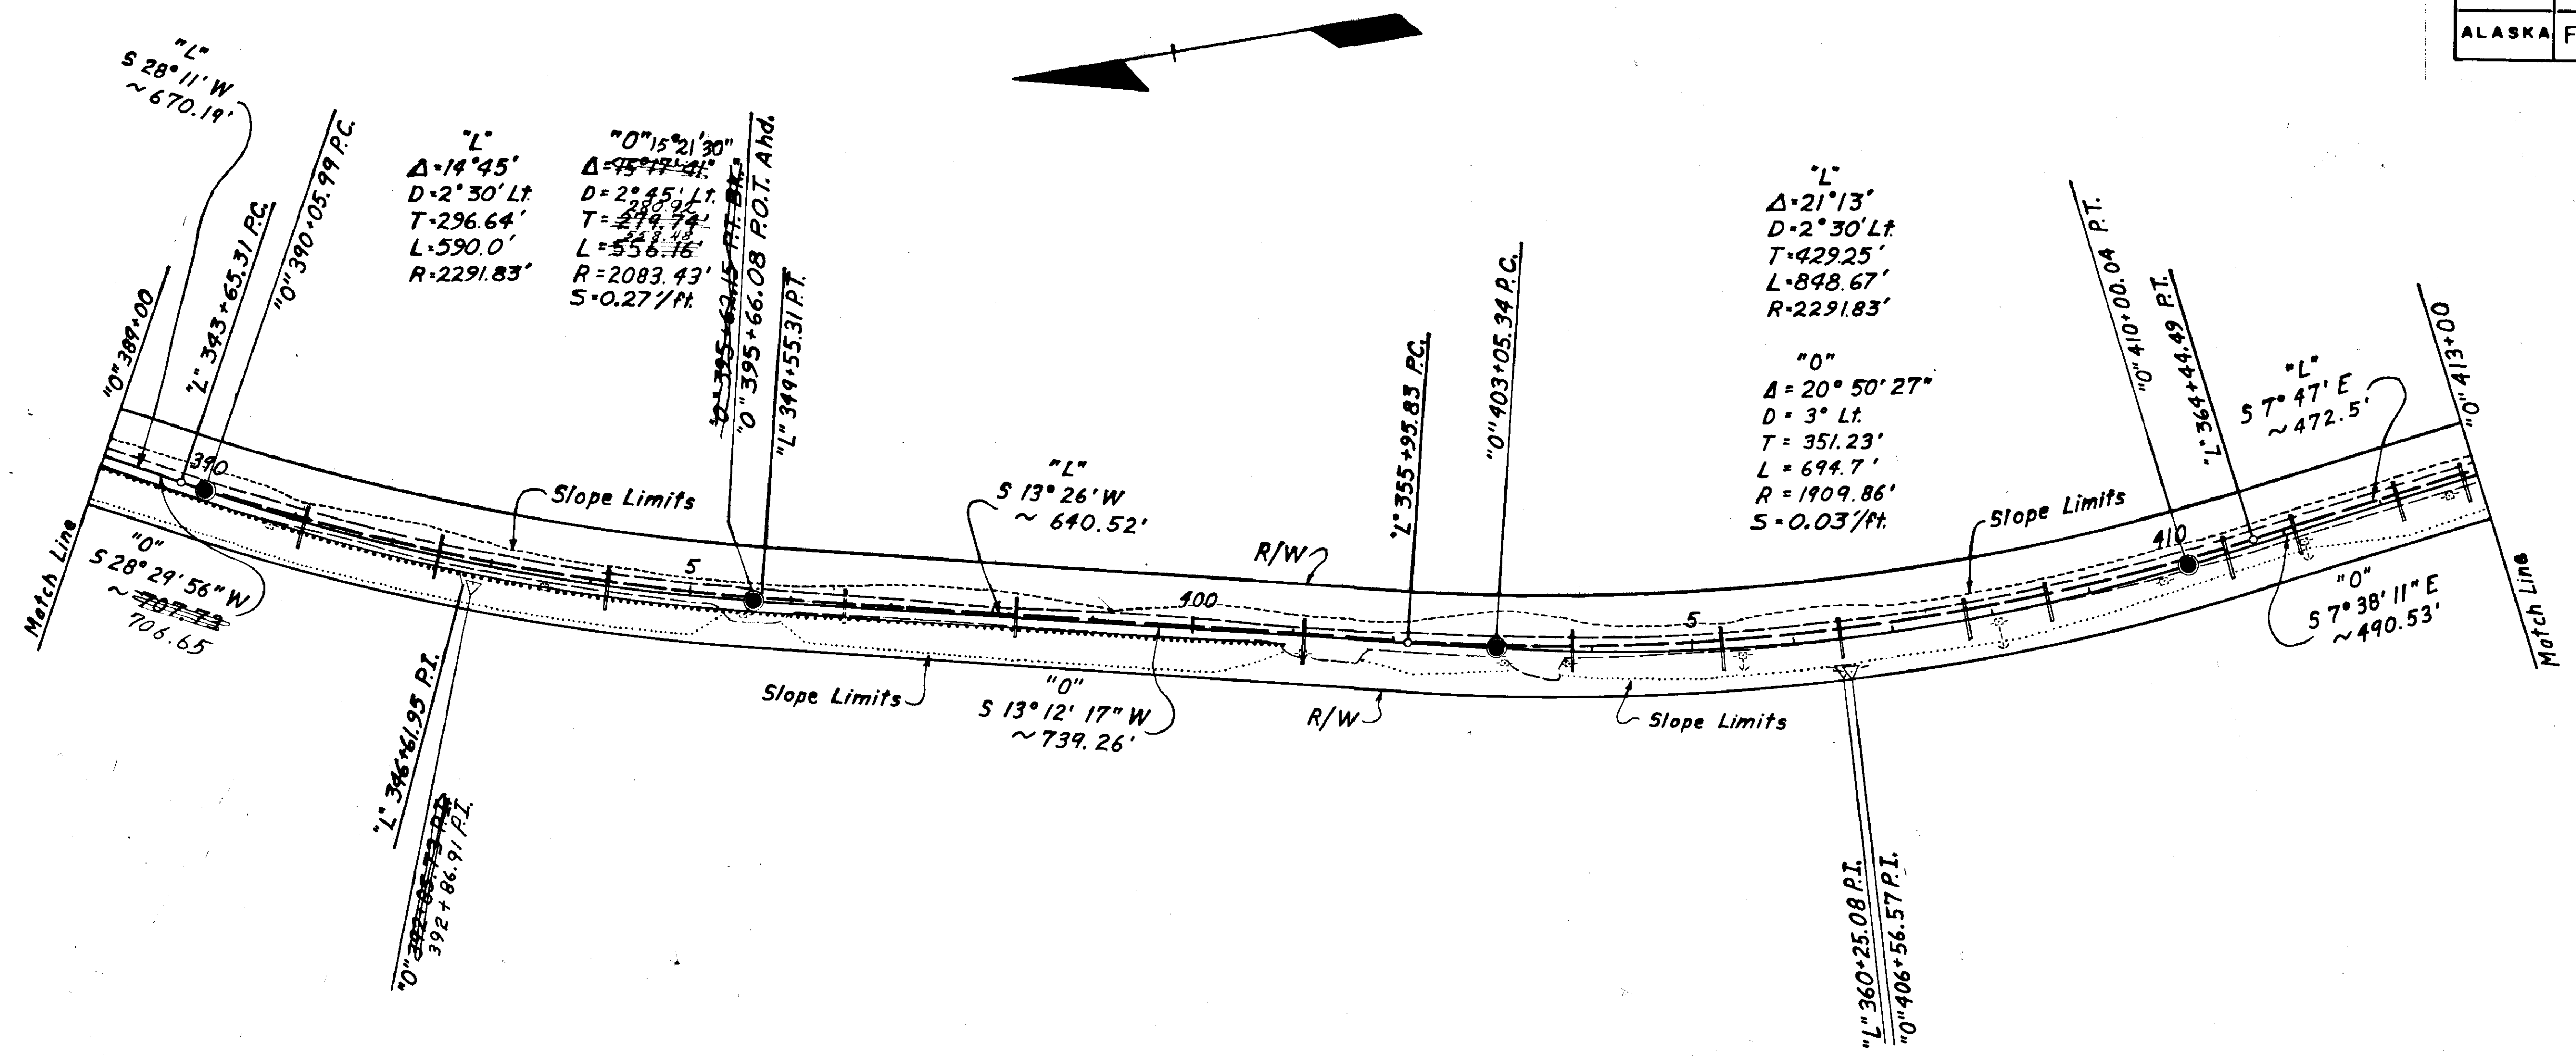


T.B.M. #8 Painted sharp point on rock  
 "L" 348+50, 16' Lt Elev. 32.22



T.B.M. #9 Spike in 14" Spruce  
 "L" 355+00, 60' Rt Elev. 27.59

Embankment = 6,661 Cu. Yd.  
 Unclassified Excavation = 1,547 Cu. Yd. (Includes 372 Cu. Yd. Waste)  
 Subbase Grading "B" = 1,224 Cu. Yd. from Unclassified Excavation


T.B.M. #10 Spike in 20" Spruce  
 "L" 365+80, 60' Rt Elev. 33.41

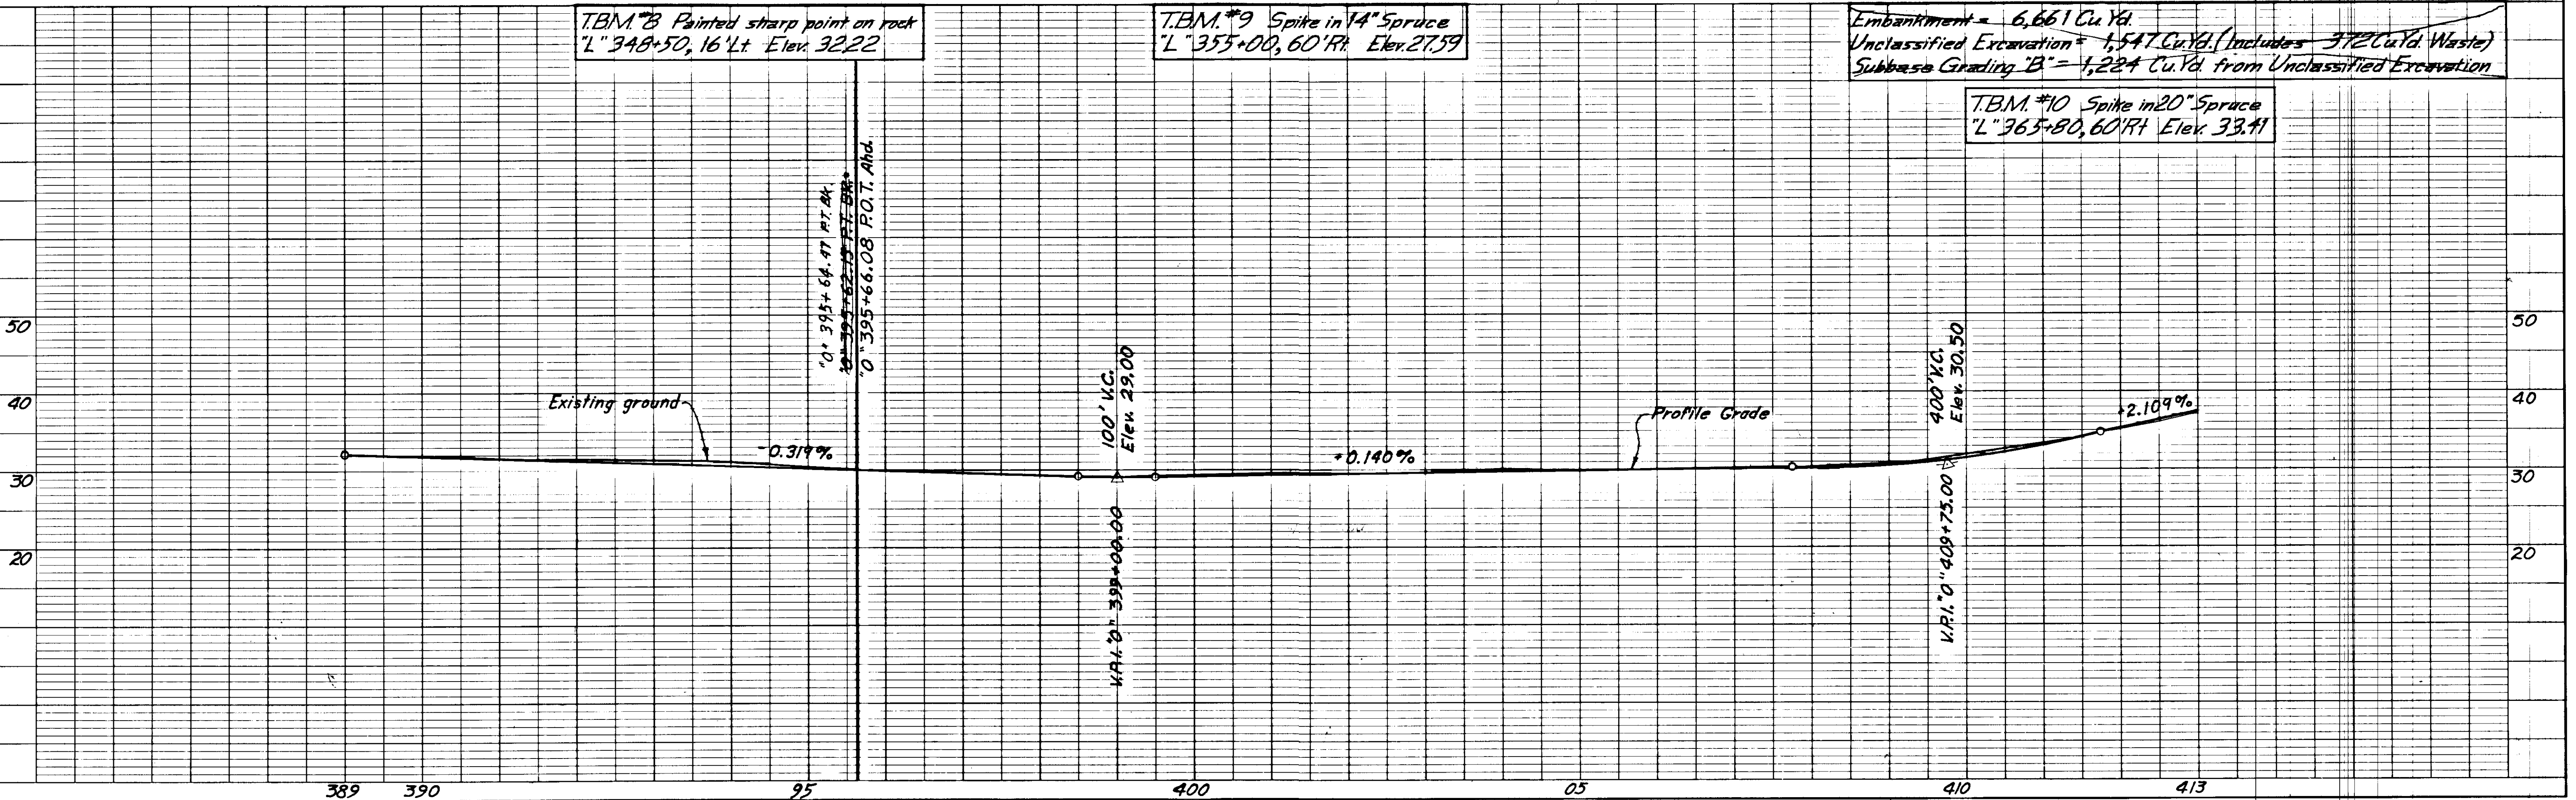

STATE	PROJECT DESIGNATION	YEAR	SHEET NO.	TOTAL SHEETS
ALASKA	FH-016-1(1)	1975	10	14

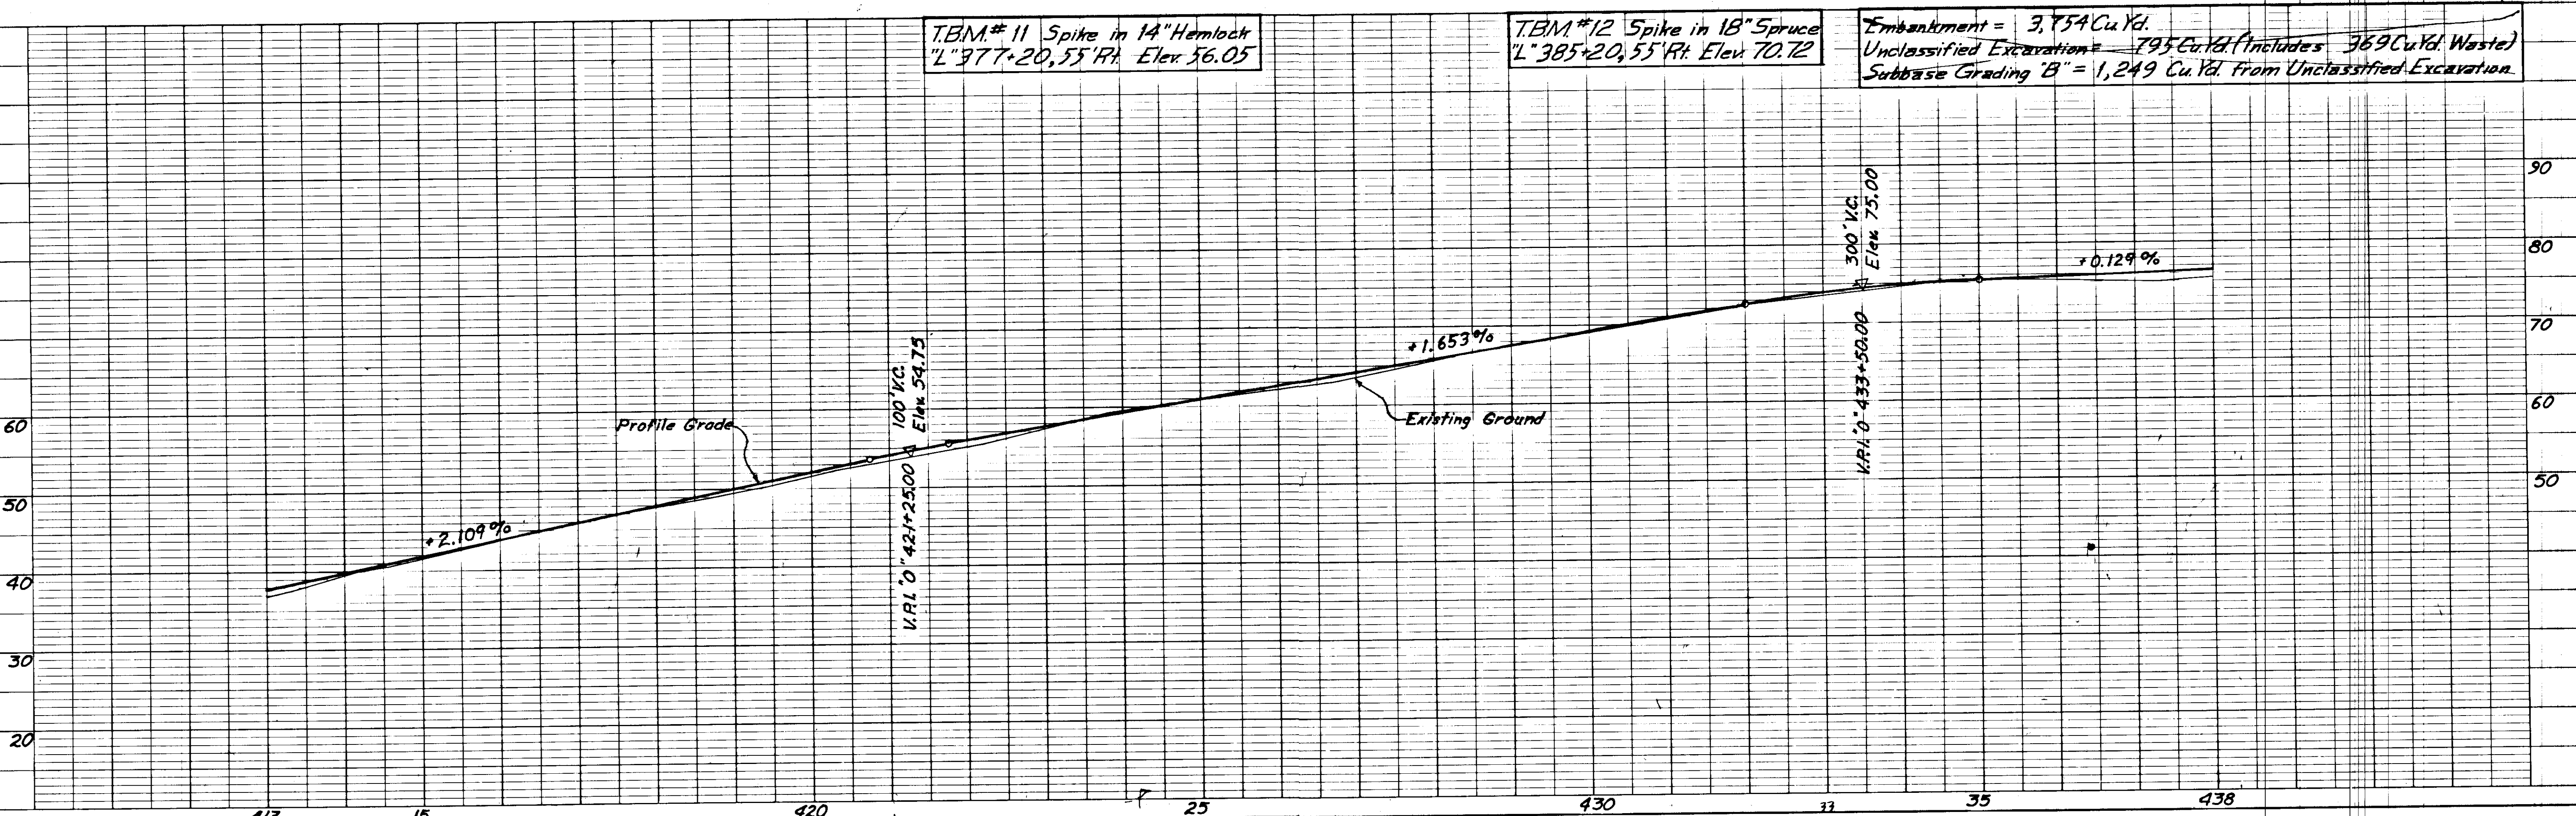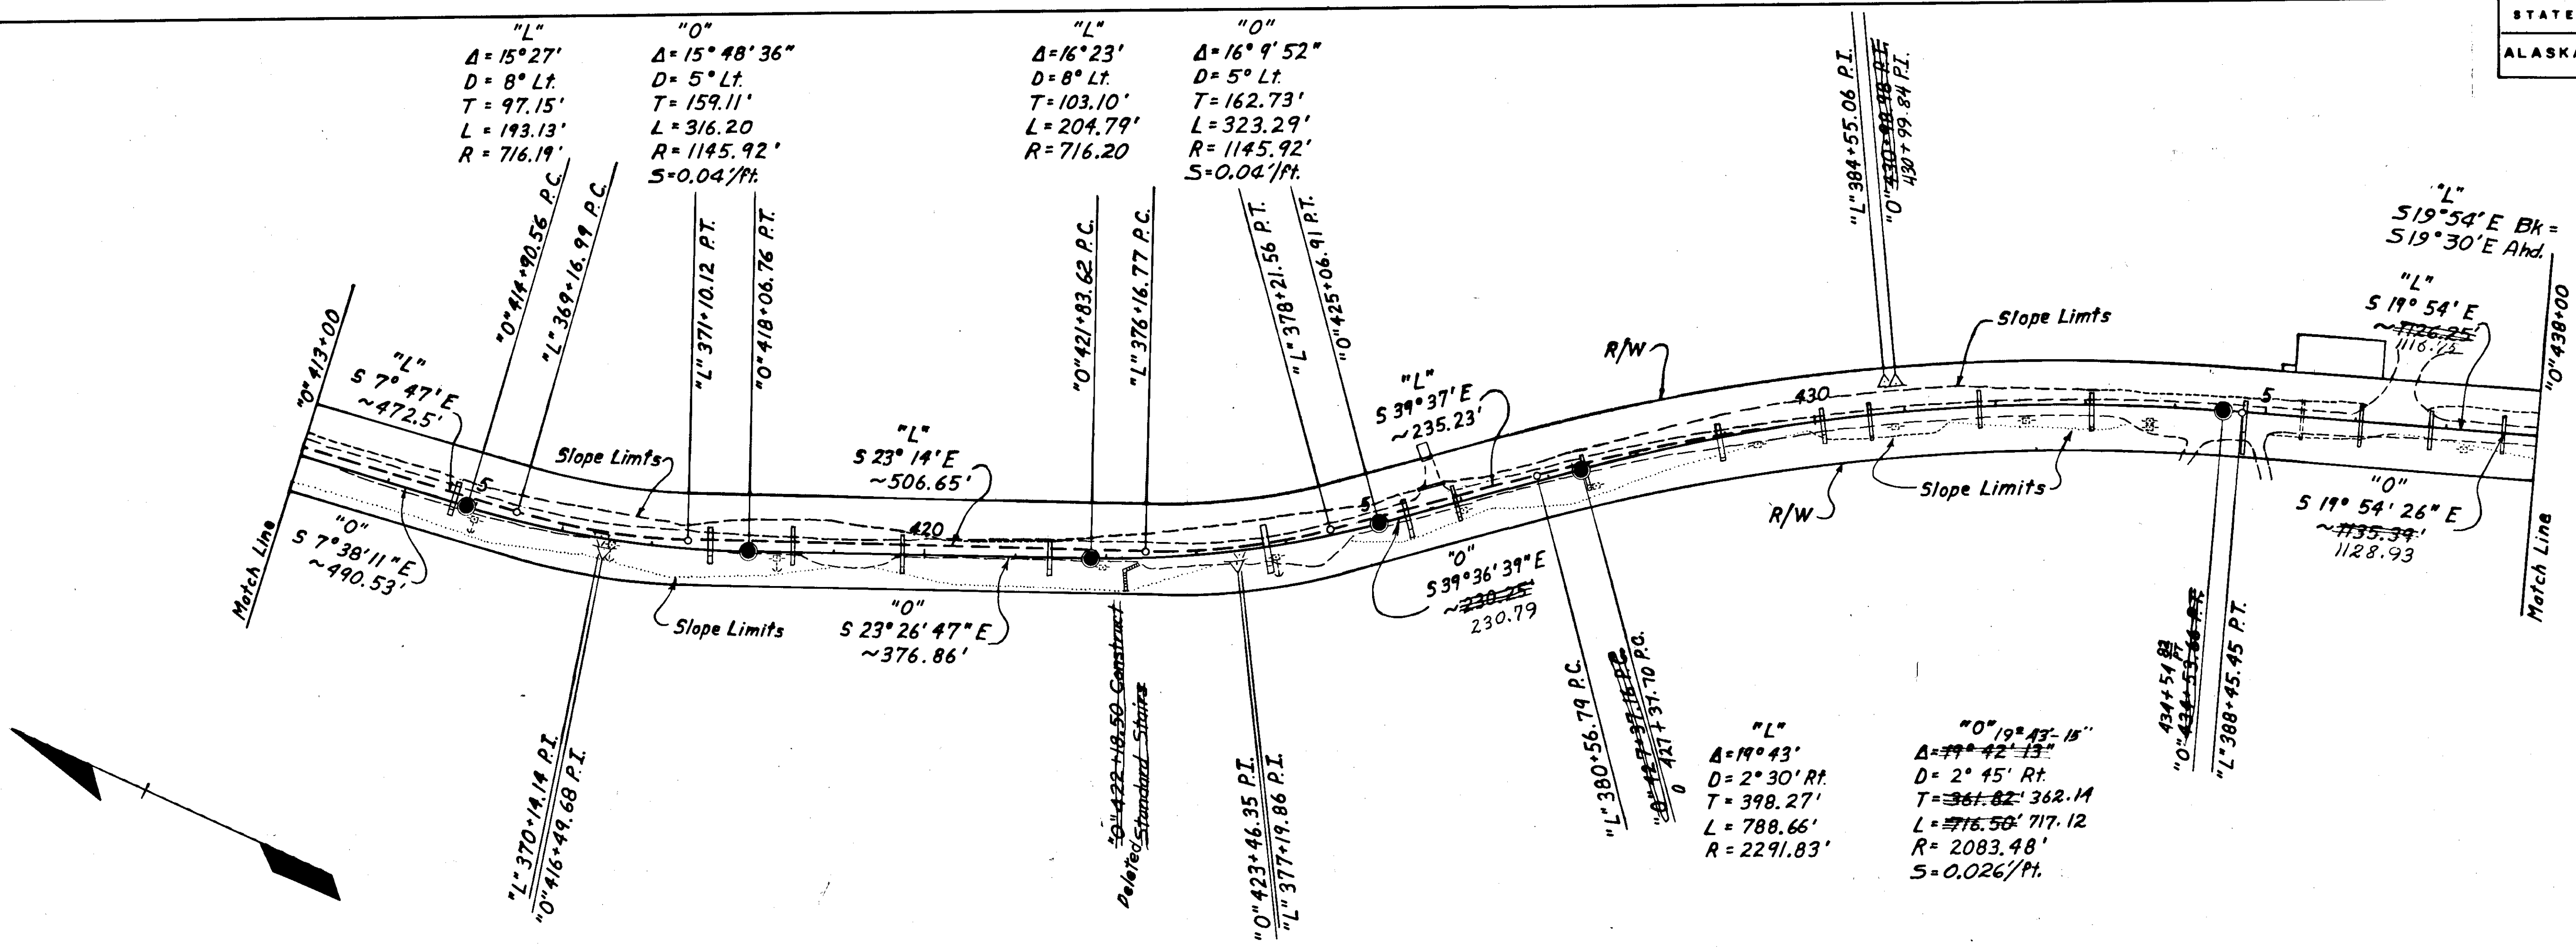


STATE	PROJECT DESIGNATION	YEAR	SHEET NO.	TOTAL SHEETS
ALASKA	FH-016-1(1)	1975	11	14

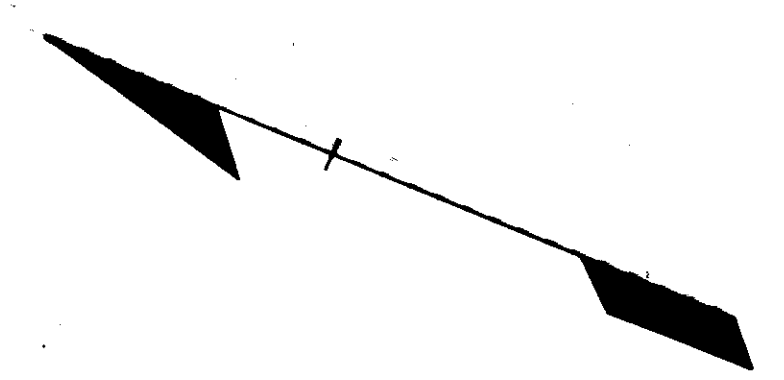

$\Delta = 8^{\circ}33'$   
 $D = 4^{\circ} Lt$   
 $T = 107.07'$   
 $L = 213.75'$   
 $R = 1432.39'$

$\Delta = 8^{\circ}34'$   
 $D = 3^{\circ}45' Lt$   
 $T = 108.76'$   
 $L = 217.14'$   
 $R = 1527.89'$   
 $S = 0.04'/ft$

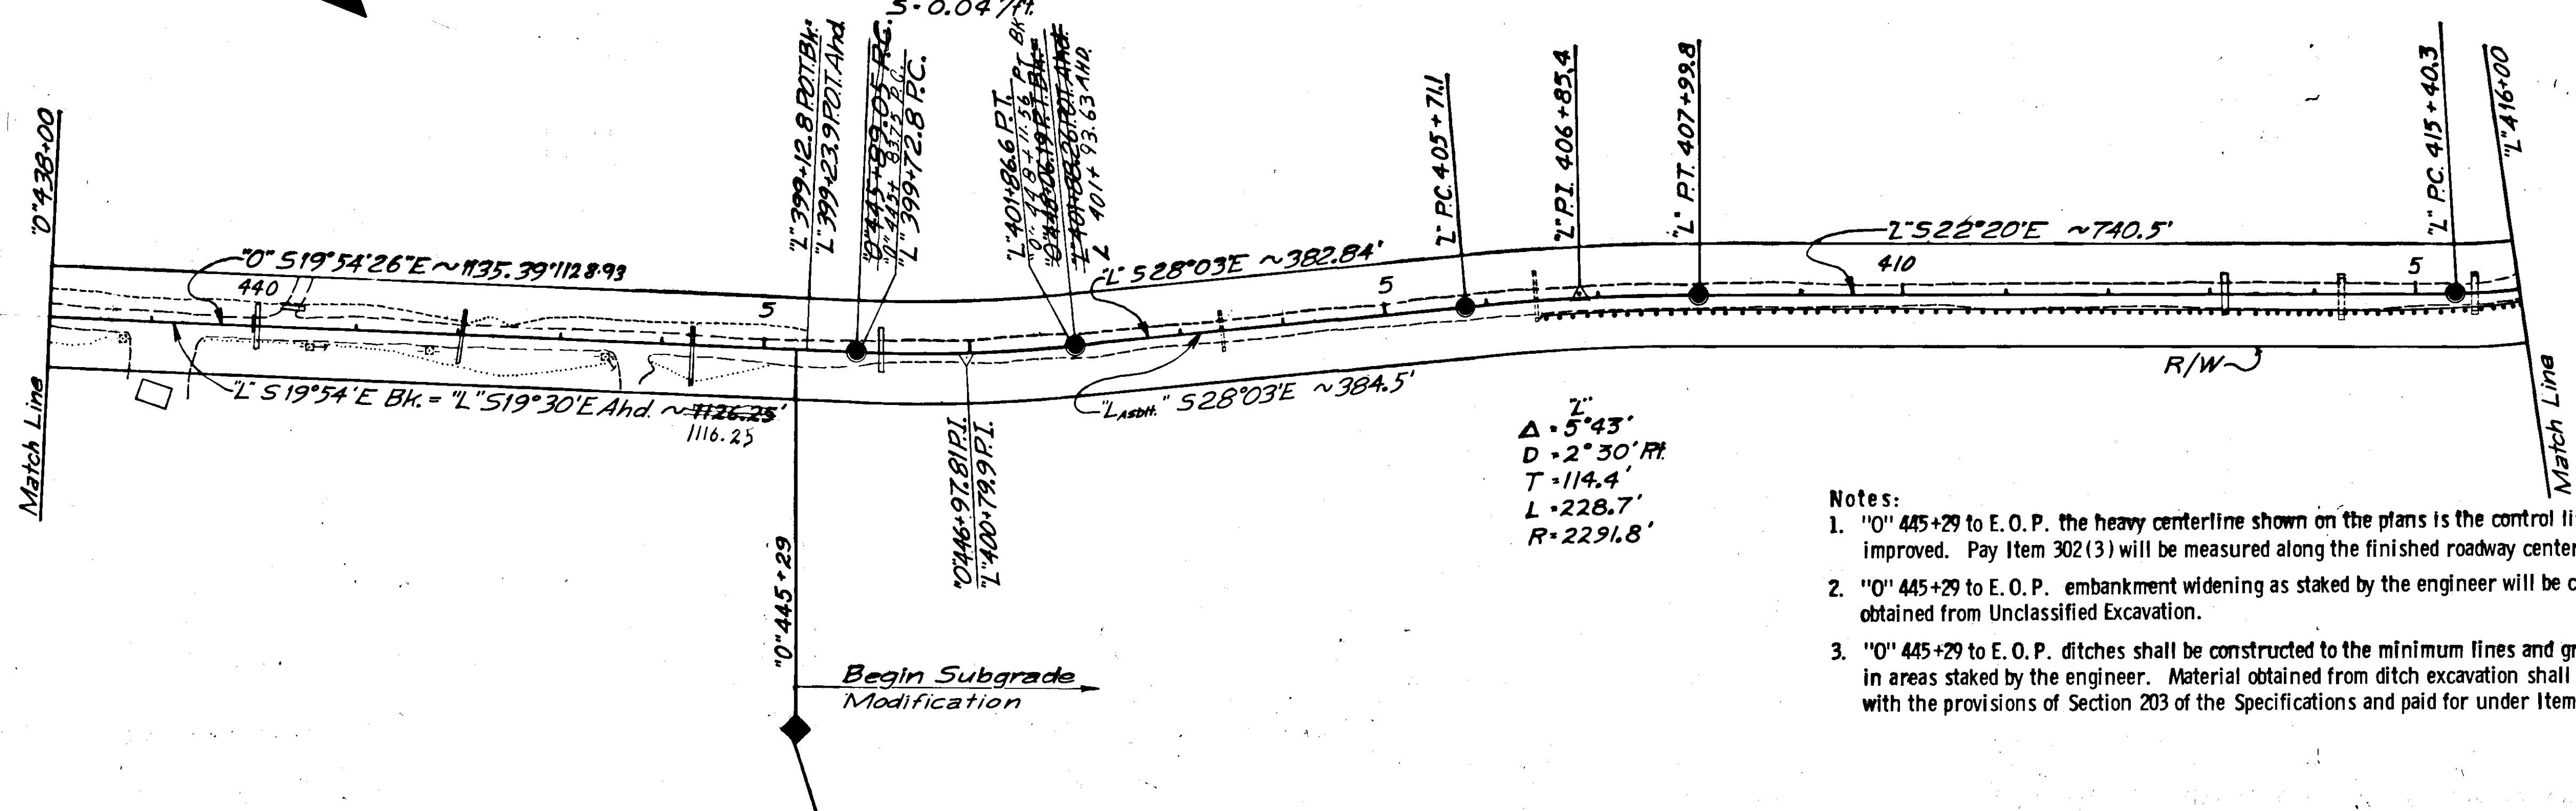

$\Delta = 5^{\circ}43'$   
 $D = 2^{\circ}30' Rt$   
 $T = 114.4'$   
 $L = 228.7'$   
 $R = 2291.8'$

- Notes:
- "0" 445+29 to E.O.P. the heavy centerline shown on the plans is the control line. The existing roadway is to be improved. Pay Item 302(3) will be measured along the finished roadway centerline.
  - "0" 445+29 to E.O.P. embankment widening as staked by the engineer will be constructed of suitable material obtained from Unclassified Excavation.
  - "0" 445+29 to E.O.P. ditches shall be constructed to the minimum lines and grades shown on the typical section in areas staked by the engineer. Material obtained from ditch excavation shall be utilized or wasted in accordance with the provisions of Section 203 of the Specifications and paid for under Item 203(3).


Sta 0+38+00 to 0+445+29  
 Embankment = 779 Cu.Yd.  
 Unclassified Excavation = 322 Cu.Yd. (includes 309 Cu.Yd. Waste)  
 Subbase Grading "B" = 391 Cu.Yd. from Unclassified Excavation

0+445+29 to E.O.P.  
 Aggregate for Embankment Widening = 9,064 C.Y.  
 from Unclassified Excavation shts. #6 - #11,  
 Subbase Grading "B" = 4,323 C.Y.  
 from Unclassified Excavation shts. #6 - #11.  
 Unclassified Excavation = 4,743 C.Y. (All waste)



T.B.M.#15 Spike in 10" Hemlock  
 "L" 408+15, 50' Rt. Elev. 128.19

T.B.M.#13 Spike in 18" Spruce  
 "L" 393+10, 60' Rt. Elev. 77.02



T.B.M.#14 Spike in 26" Spruce  
 "L" 394+30, 55' Rt. Elev. 87.34

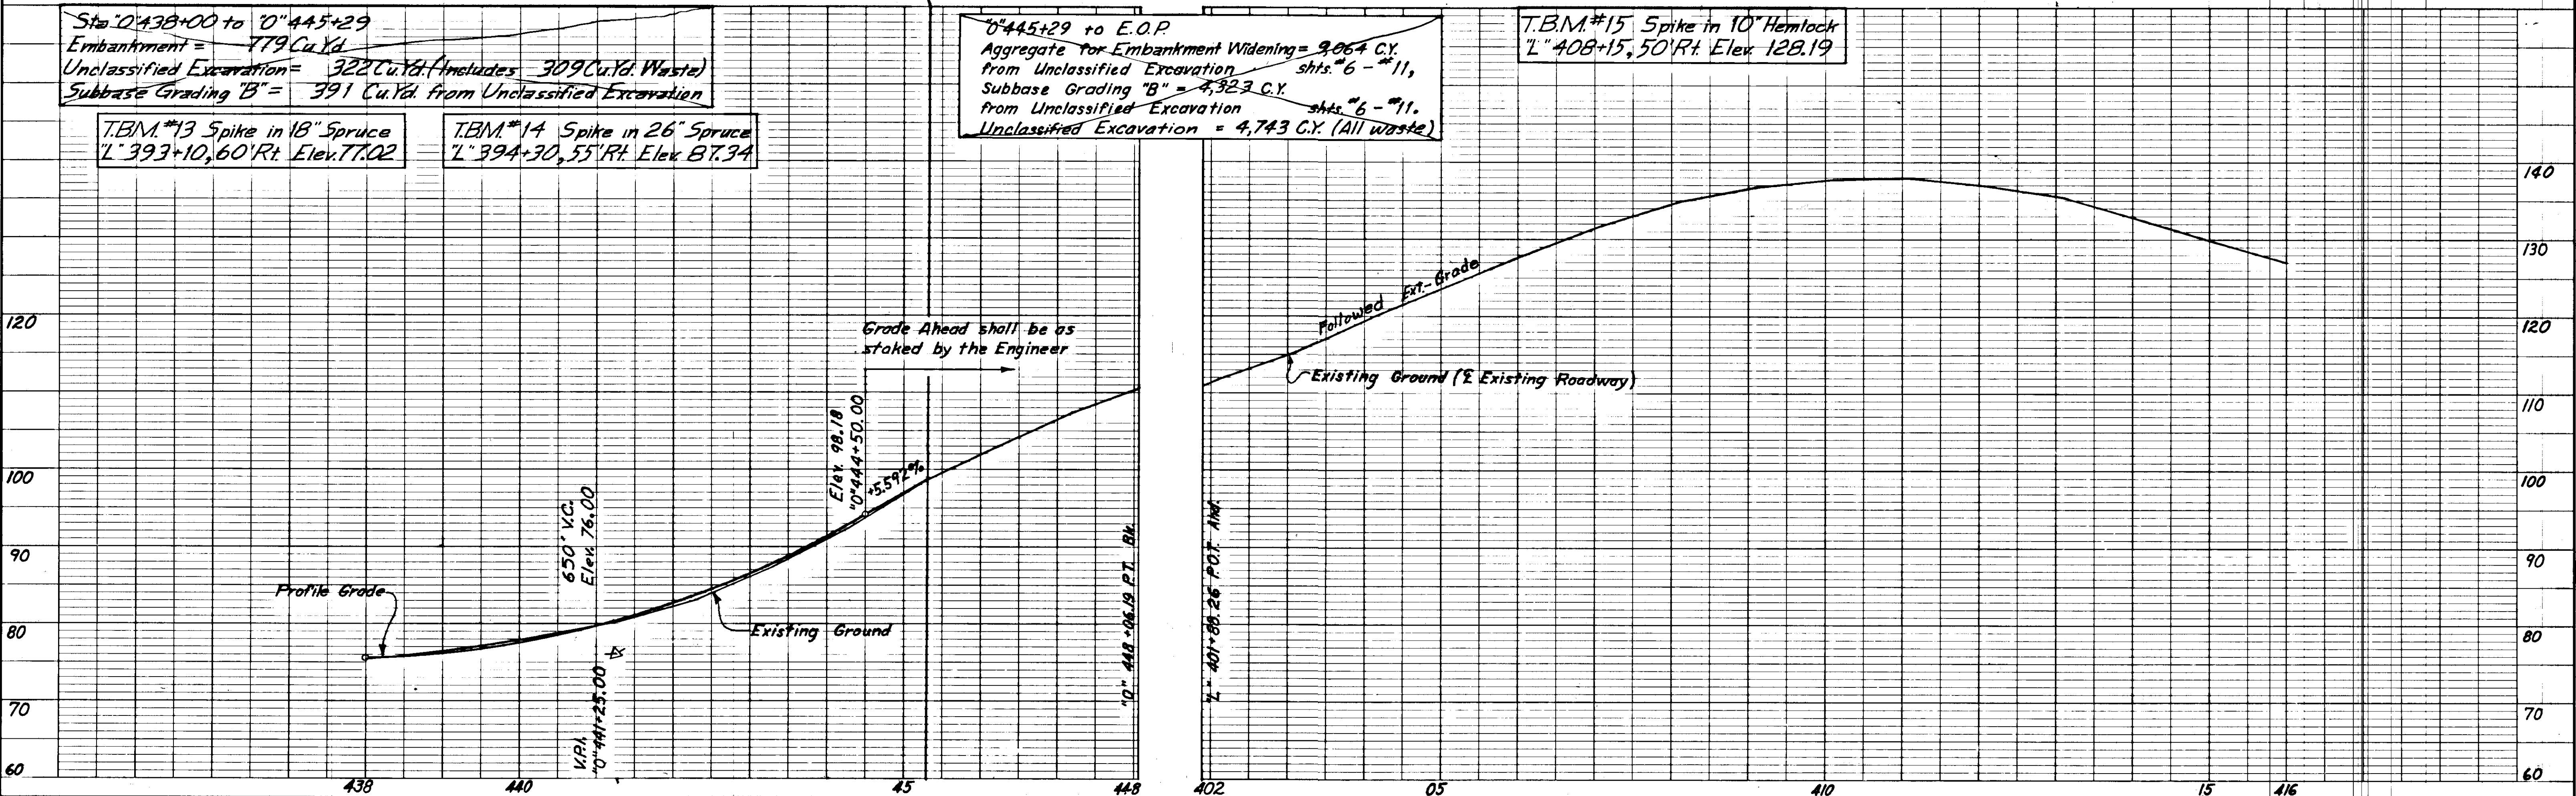


STATE	PROJECT DESIGNATION	YEAR	SHEET NO.	TOTAL SHEETS
ALASKA	FH-016-1(I)	1975	12	14

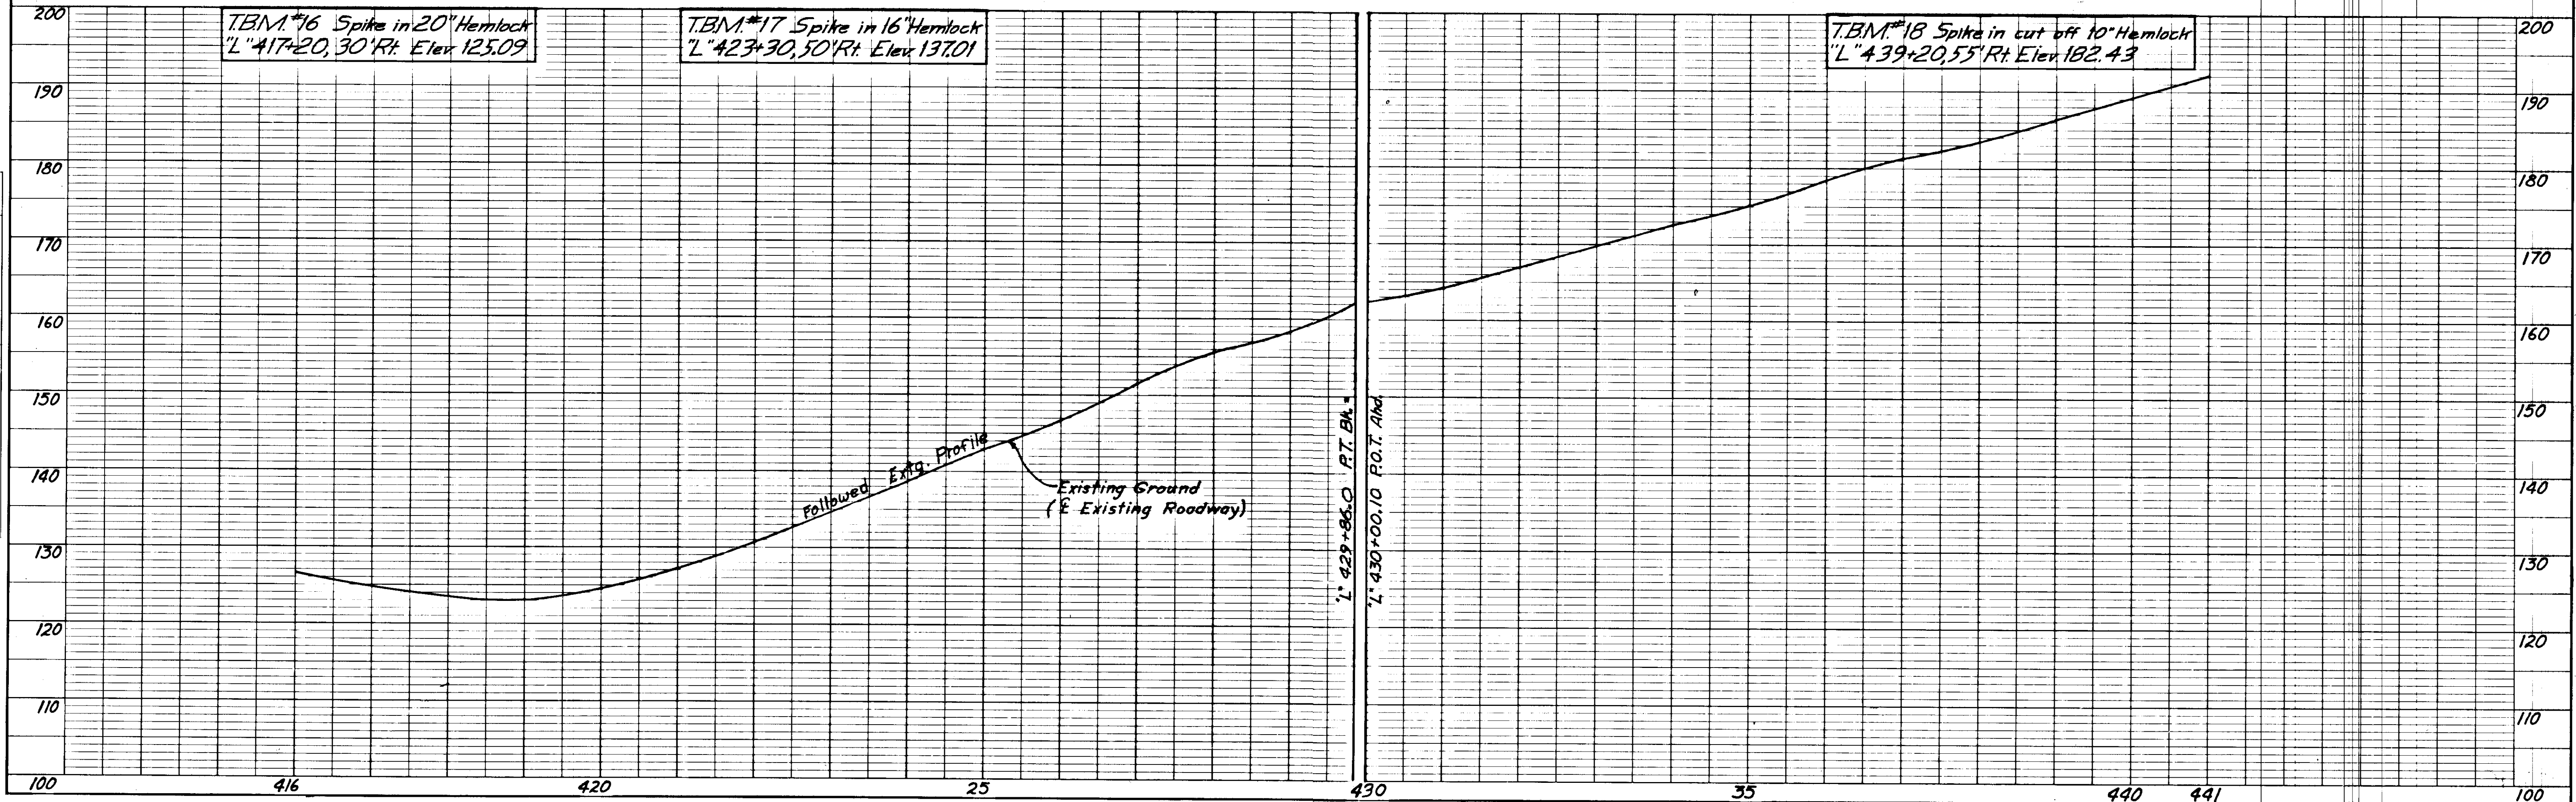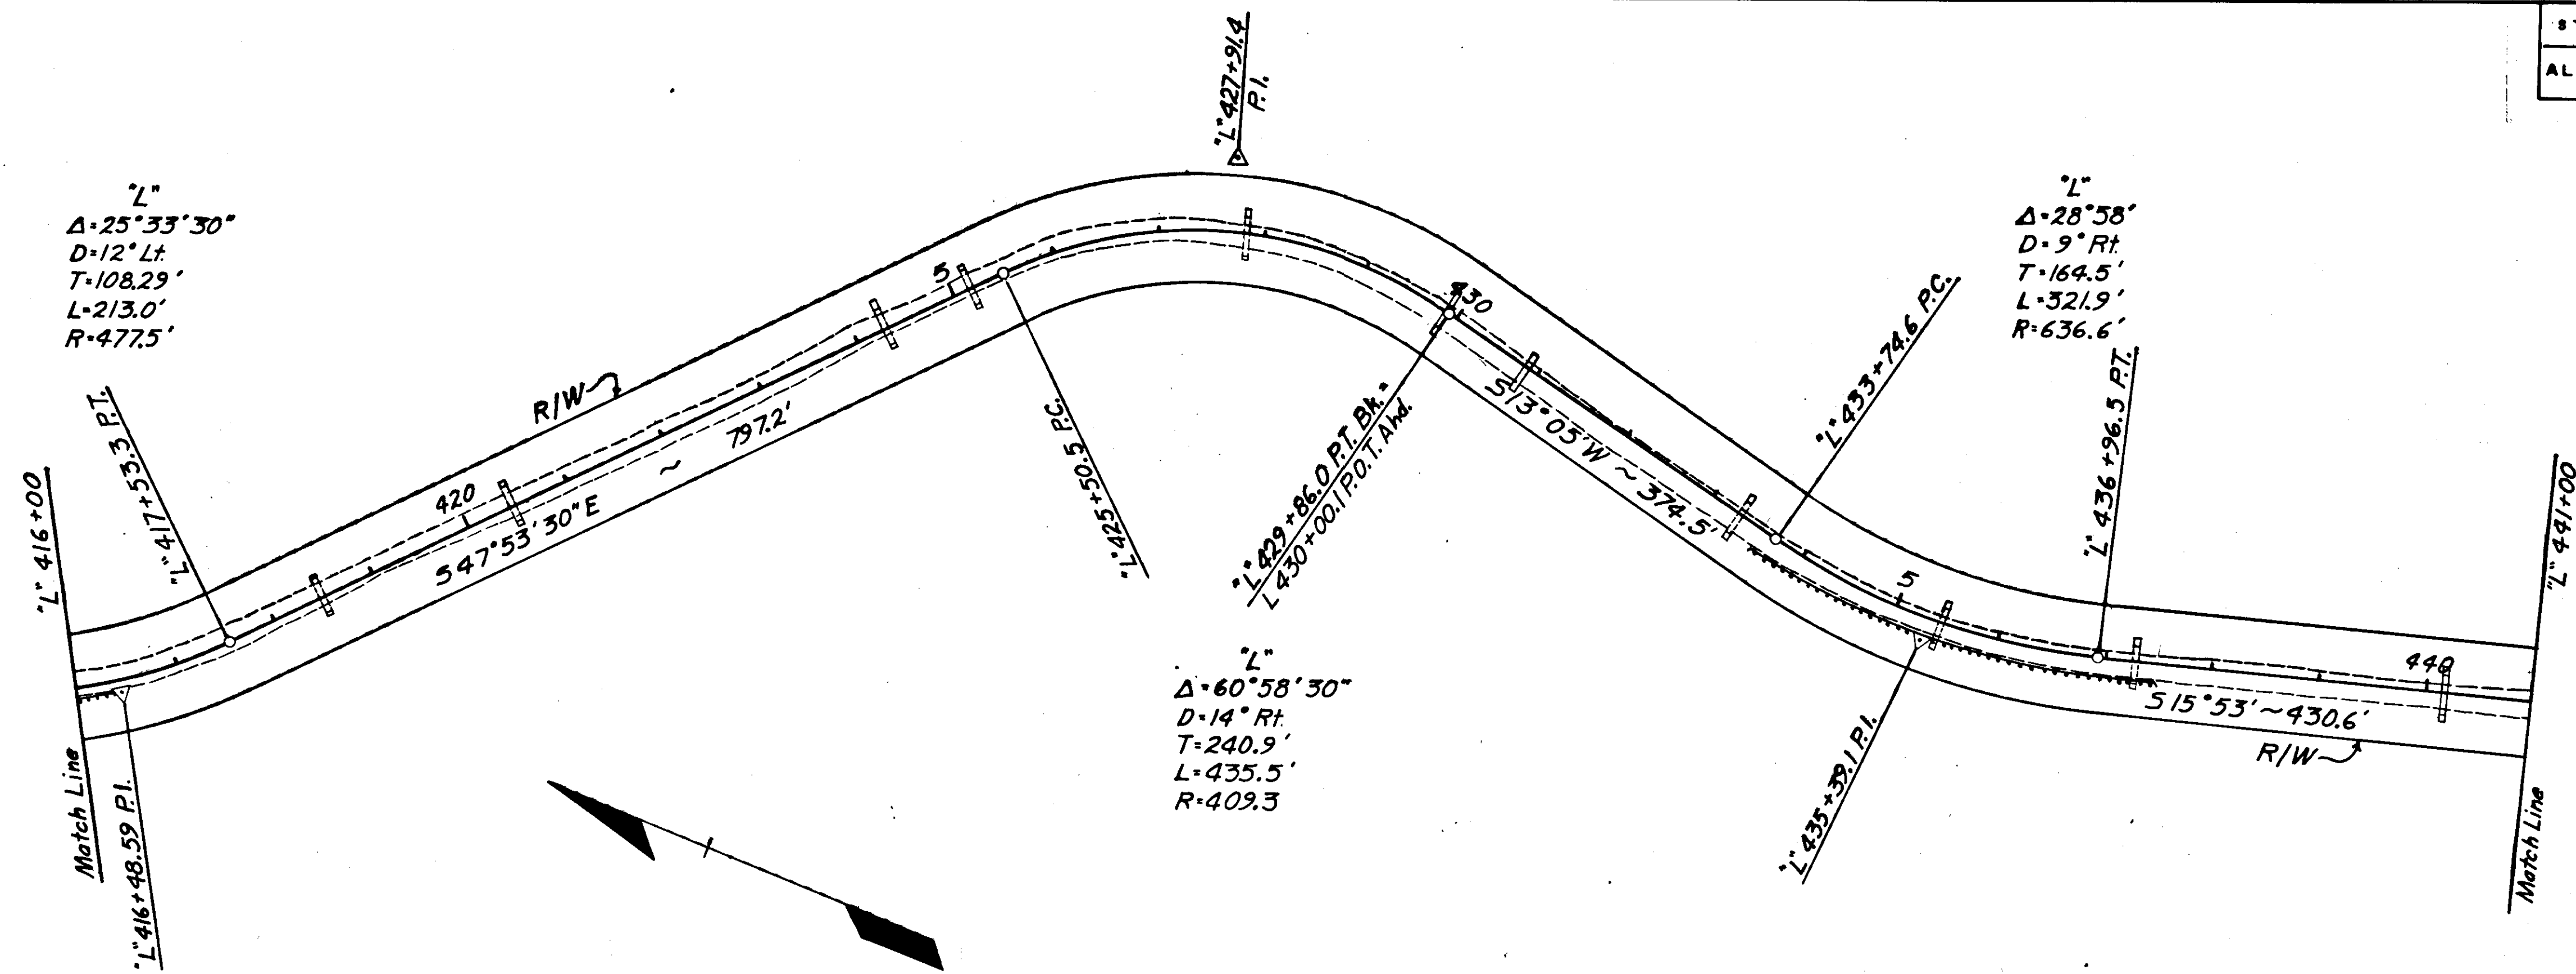

STATE	PROJECT DESIGNATION	YEAR	SHEET NO.	TOTAL SHEETS
ALASKA	FH - 016 - 1 (1)	1975	13	14

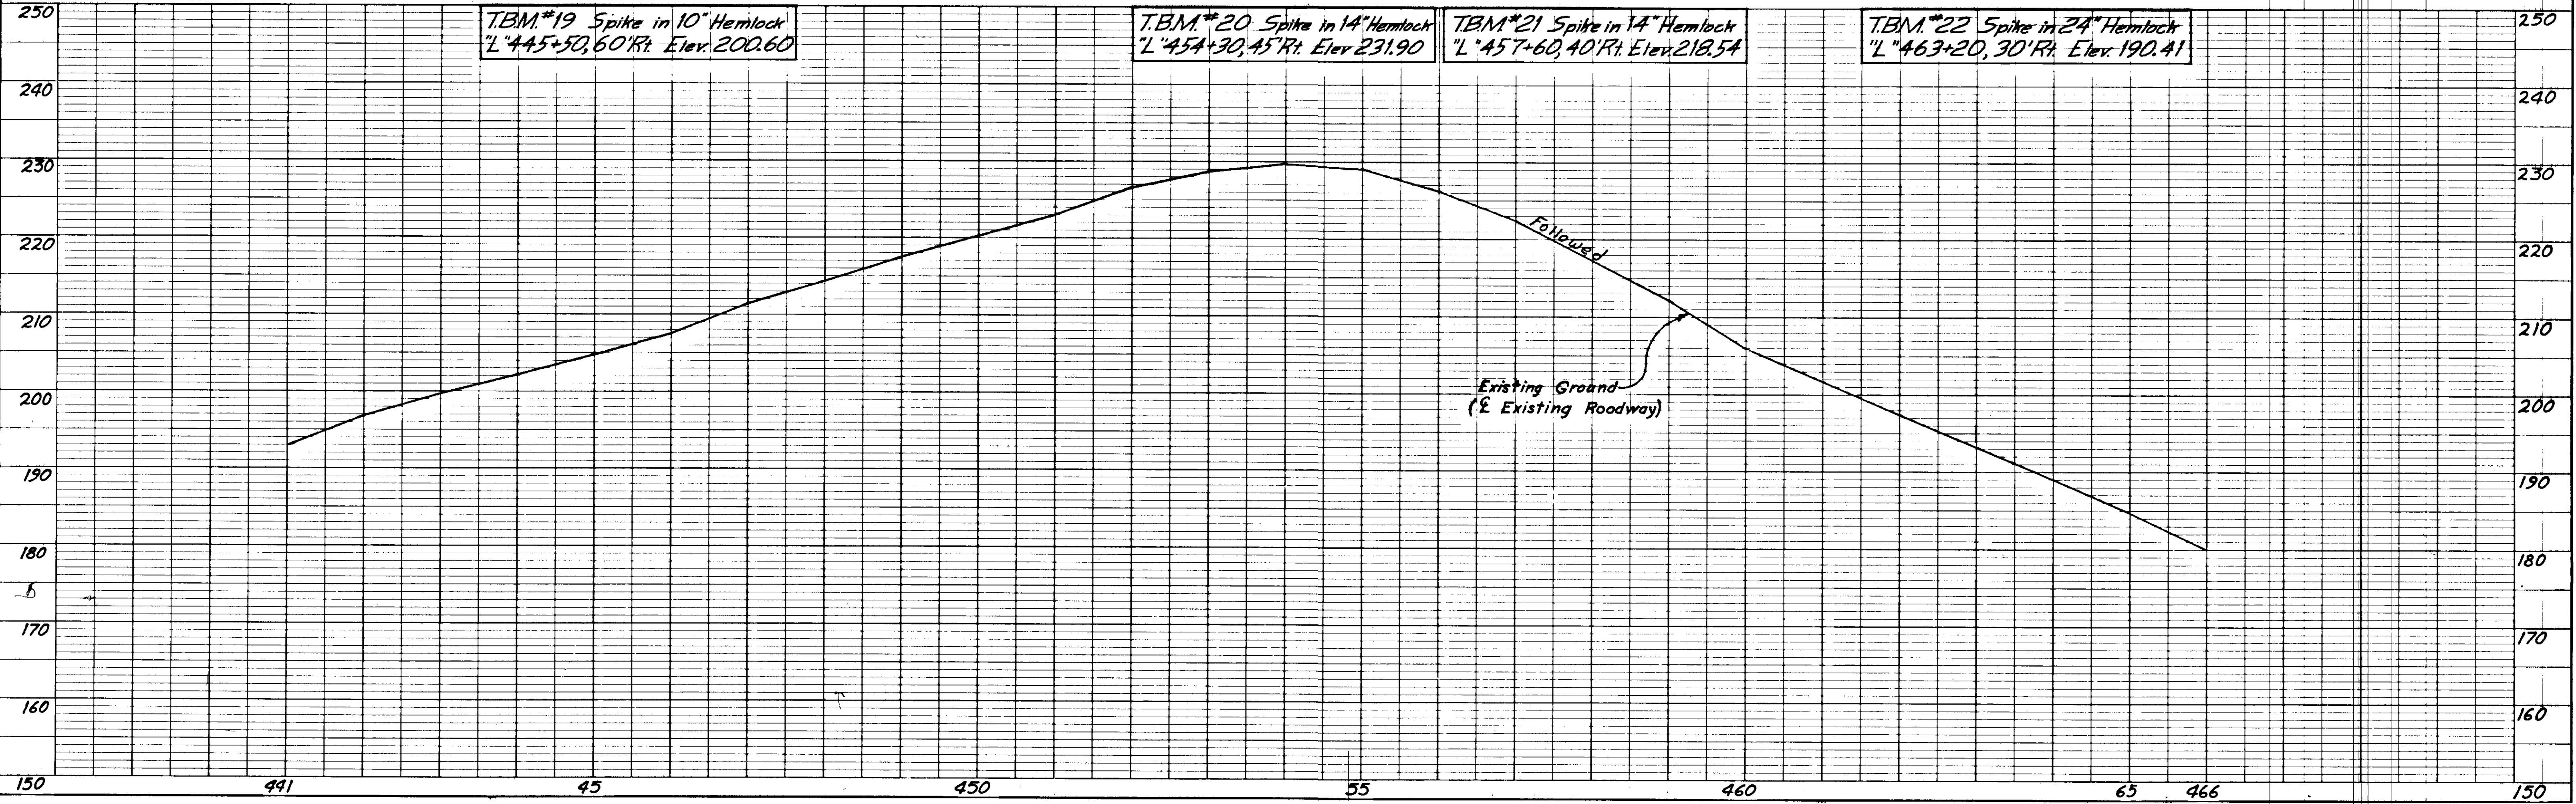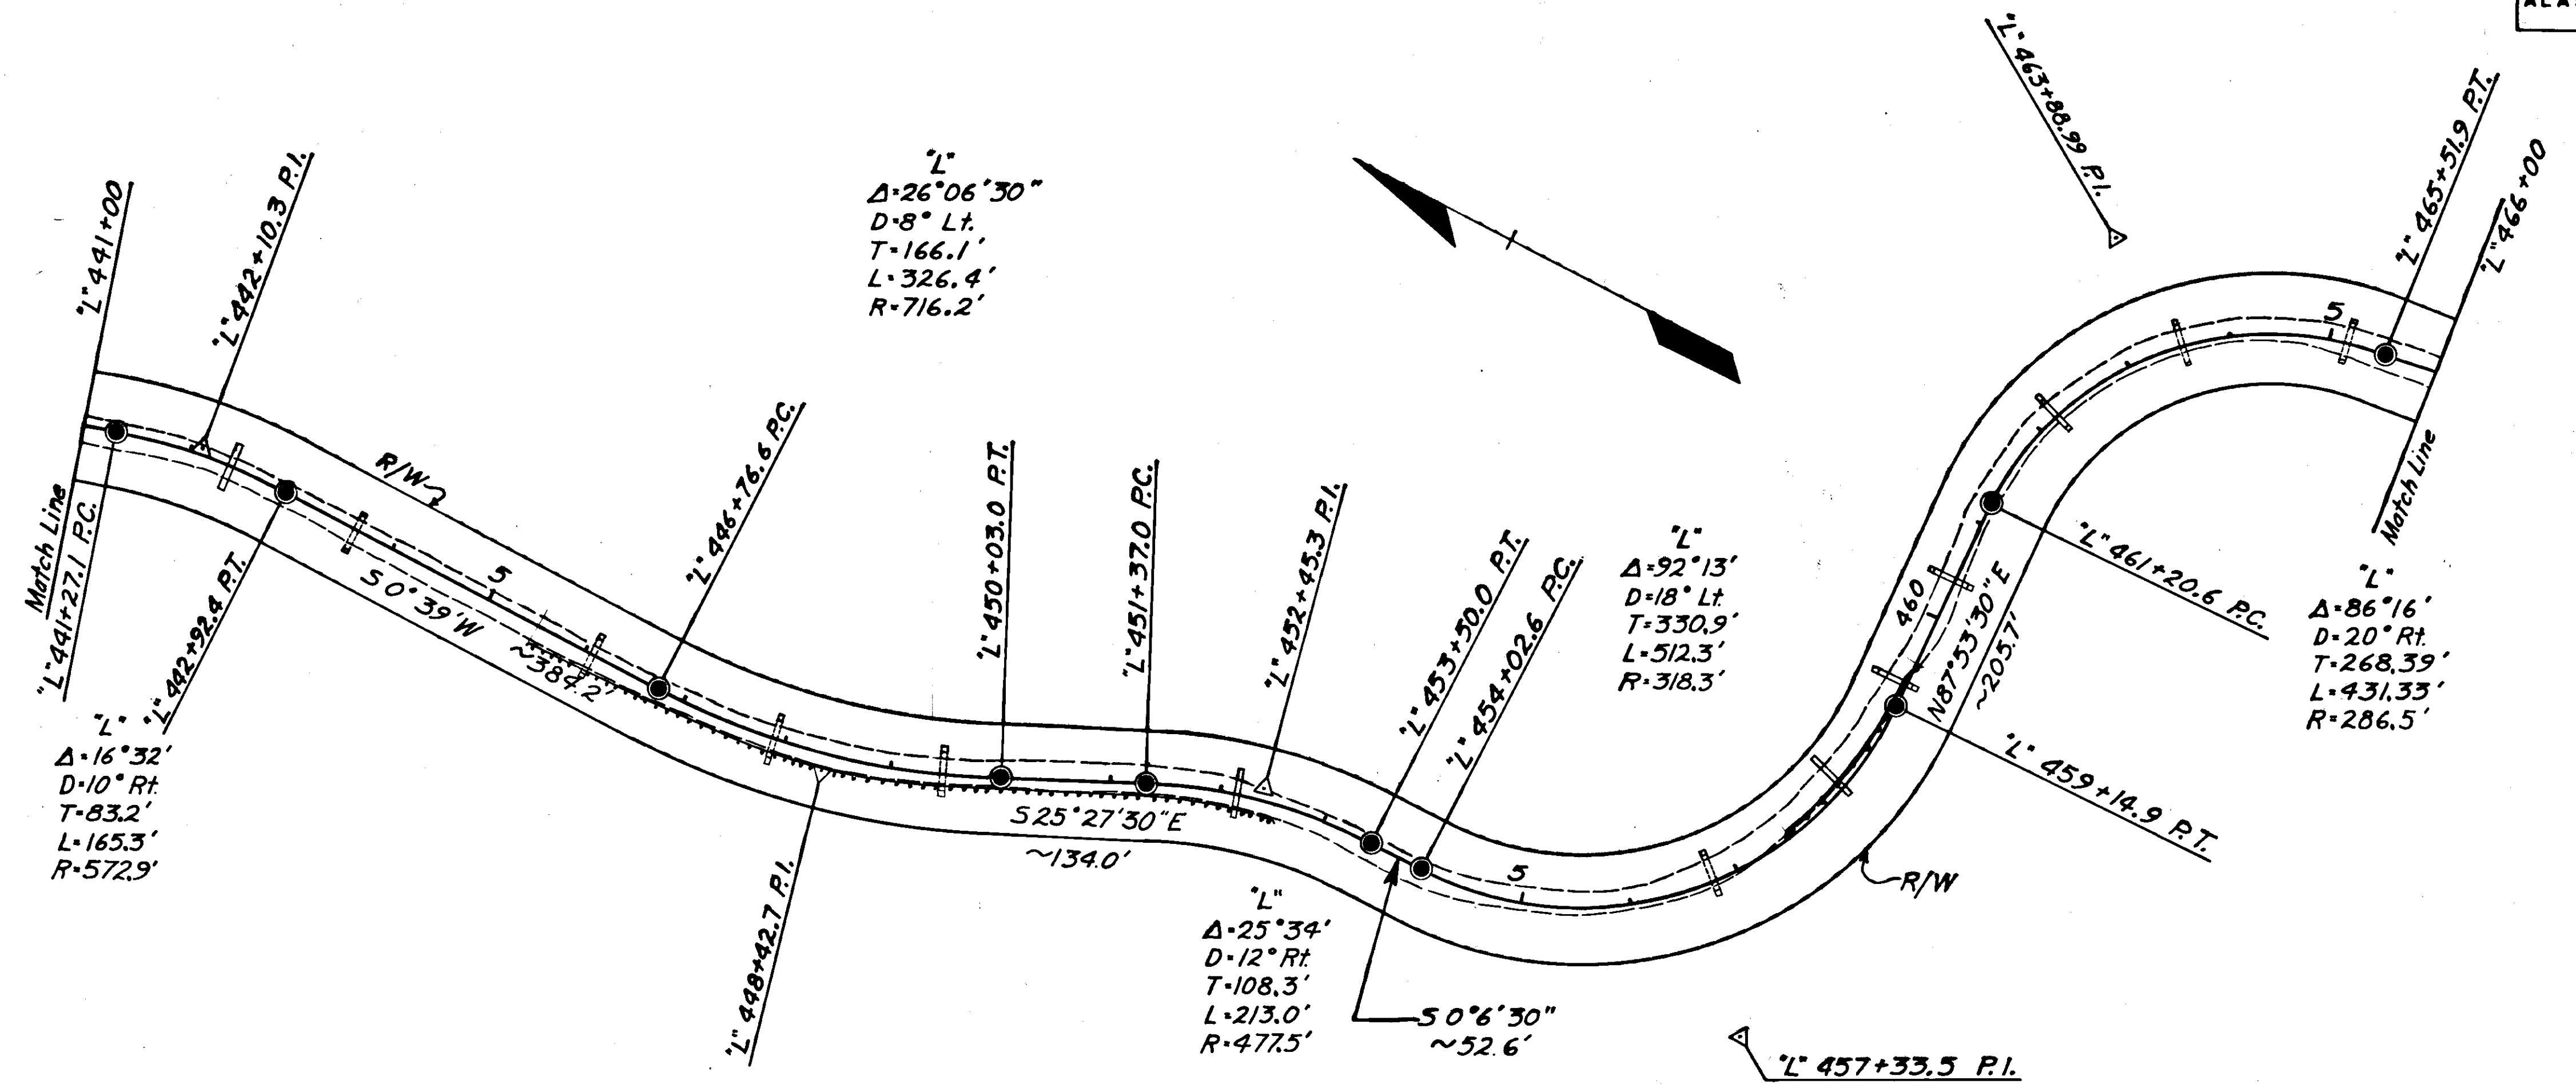

STATE	PROJECT DESIGNATION	YEAR	SHEET NO.	TOTAL SHEETS
ALASKA	FH-016-1(I)	1975	14	14

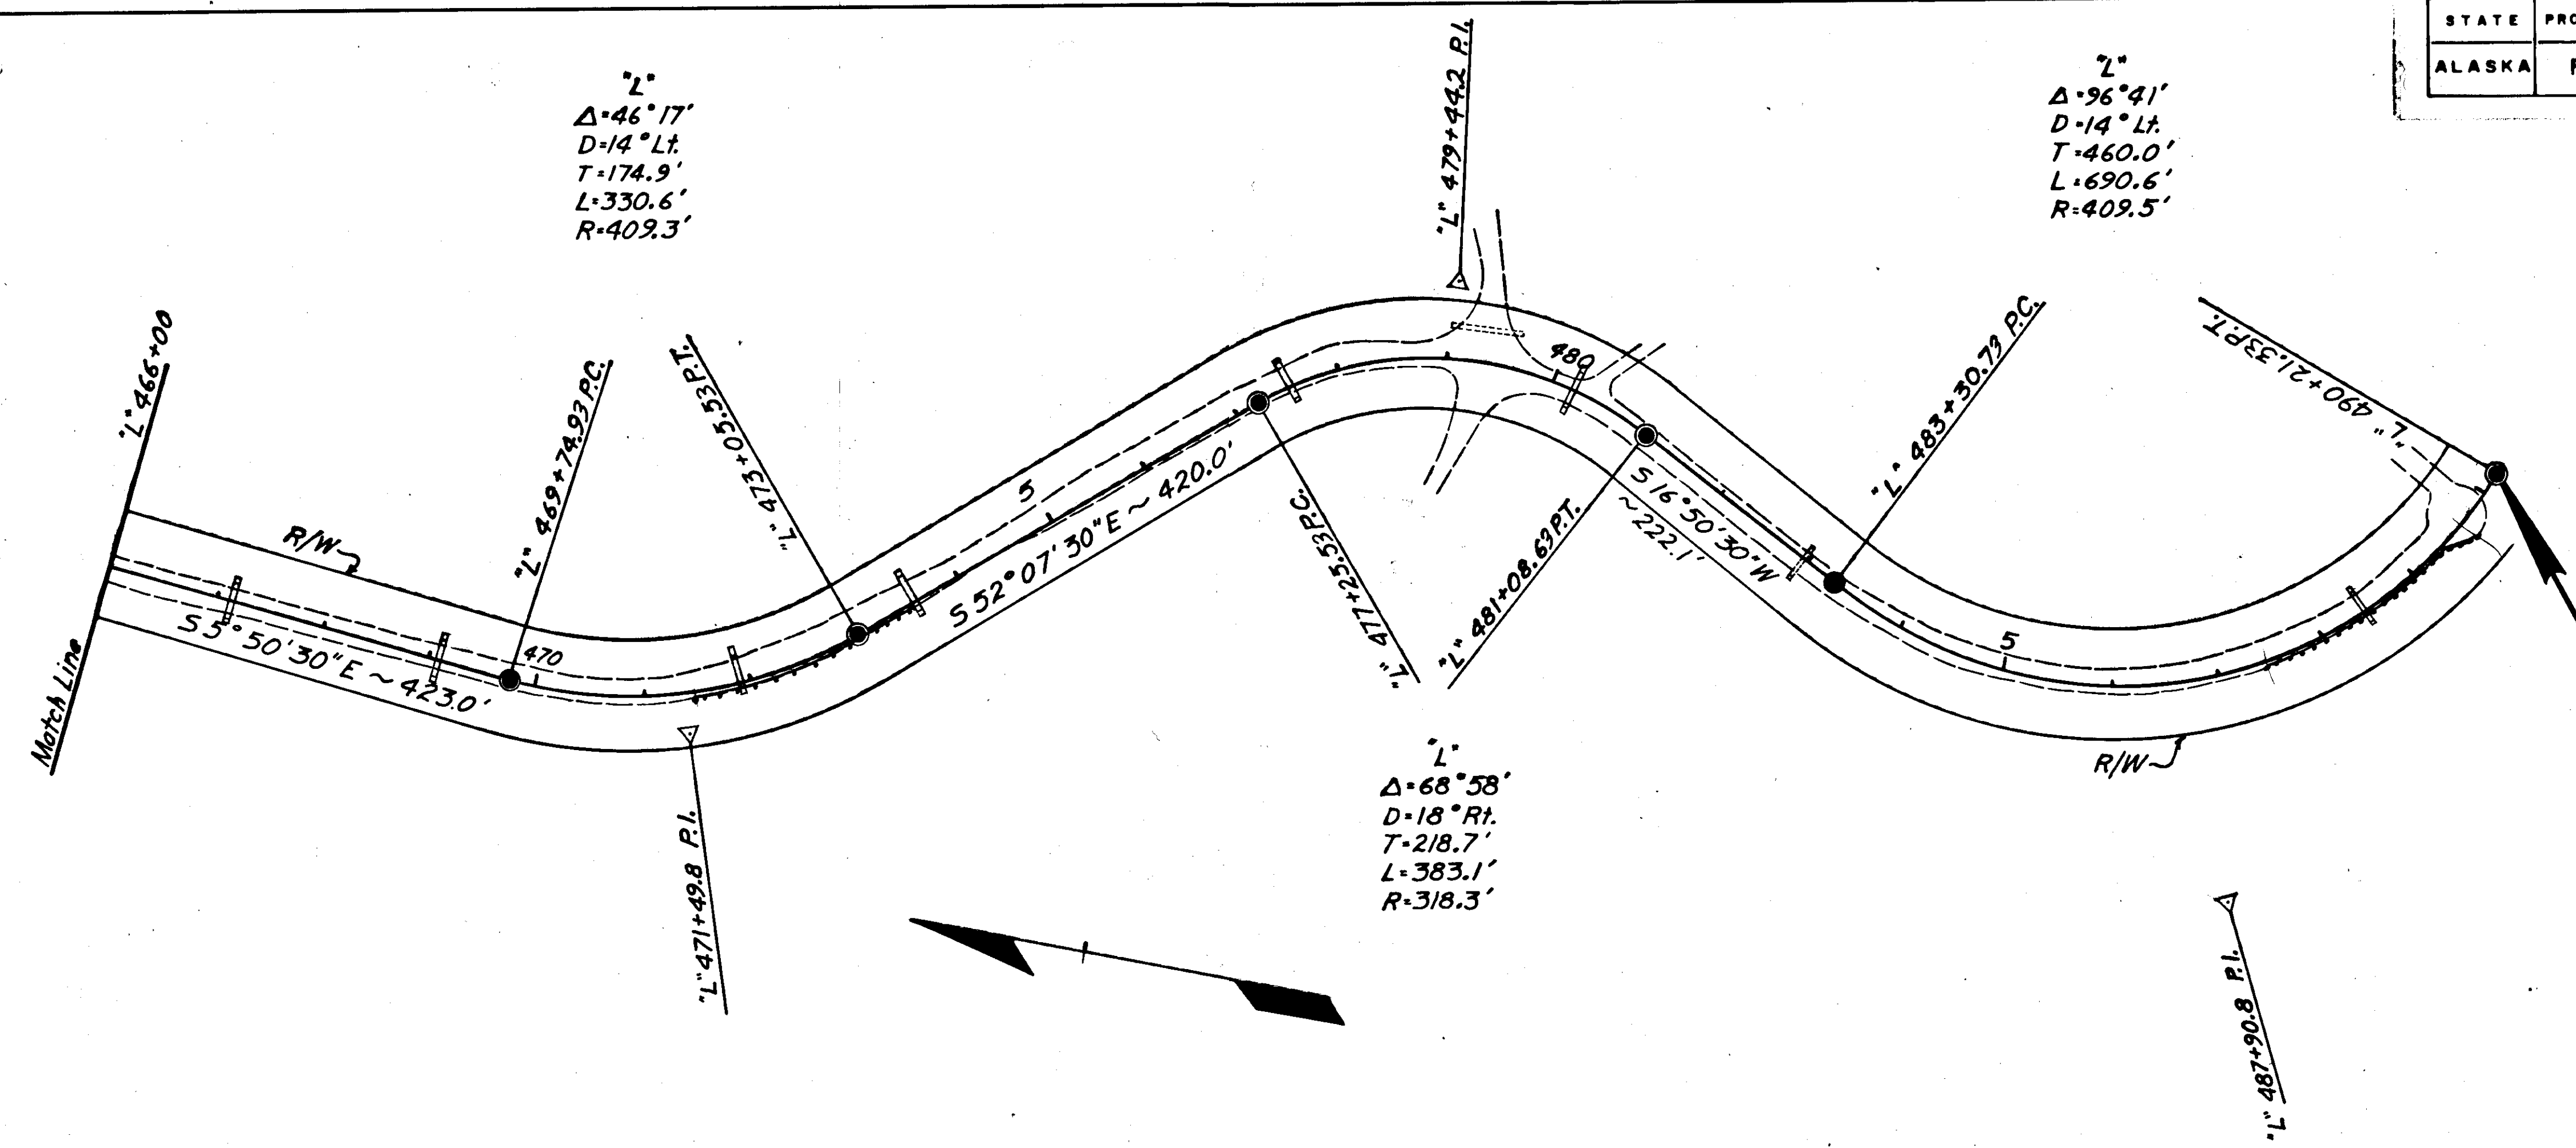

T.B.M. #23 Spike in 24" Spruce  
 "L" 468+75.40 Rt. Elev. 166.81

T.B.M. #24 Spike in 12" Hemlock  
 "L" 473+60.45 Lt. Elev. 146.91

T.B.M. #25 Spike in 16" Hemlock  
 "L" 477+25.60 Rt. Elev. 115.62

T.B.M. #26 Spike in 12" Hemlock  
 "L" 484+85.35 Lt. Elev. 78.26

**END OF PROJECT FH-016-1(I)**  
**Sta. "L" 490+21.3**

T.B.M. #27 Spike in 18" Hemlock  
 "L" 489+20.40 Rt. Elev. 53.87

