


SURVEYED TOWNSHIP 11 SOUTH RANGE 36 WEST OF THE KATEEL RIVER

Lat 64°34'18.60"N
 Long 165°57'55.17"W



NORTON

SOUND

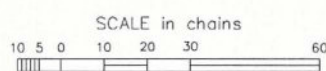

WARNING:
 This plot is the Bureau's Record of Title, and should be used only as a graphic display of the township survey data. Orders hereon do not reflect title changes which may be effected by lateral movements of rivers or other bodies. Refer to the cadastral surveys for official survey information.

TH RANGE 36 WEST OF THE KATEEL RIVER MERIDIAN, ALASKA

STATUS OF PUBLIC DOMAIN
 LAND AND MINERAL TITLES


MTP

FOR ORDERS EFFECTING DISPOSAL OR USE OF UN-IDENTIFIED LANDS WITHDRAWN FOR CLASSIFICATION MINERALS, WATER AND/OR OTHER PUBLIC PURPOSES REFER TO INDEX OF MISCELLANEOUS DOCUMENTS.

PL 92-203 Wd/ F14908, Lds W/ F14908-B

PLD 5184 Wd/ CI affects Lds/Interests not conveyed

F35186 Reindeer Gr Per affects Unapprop Lds W/ Tp

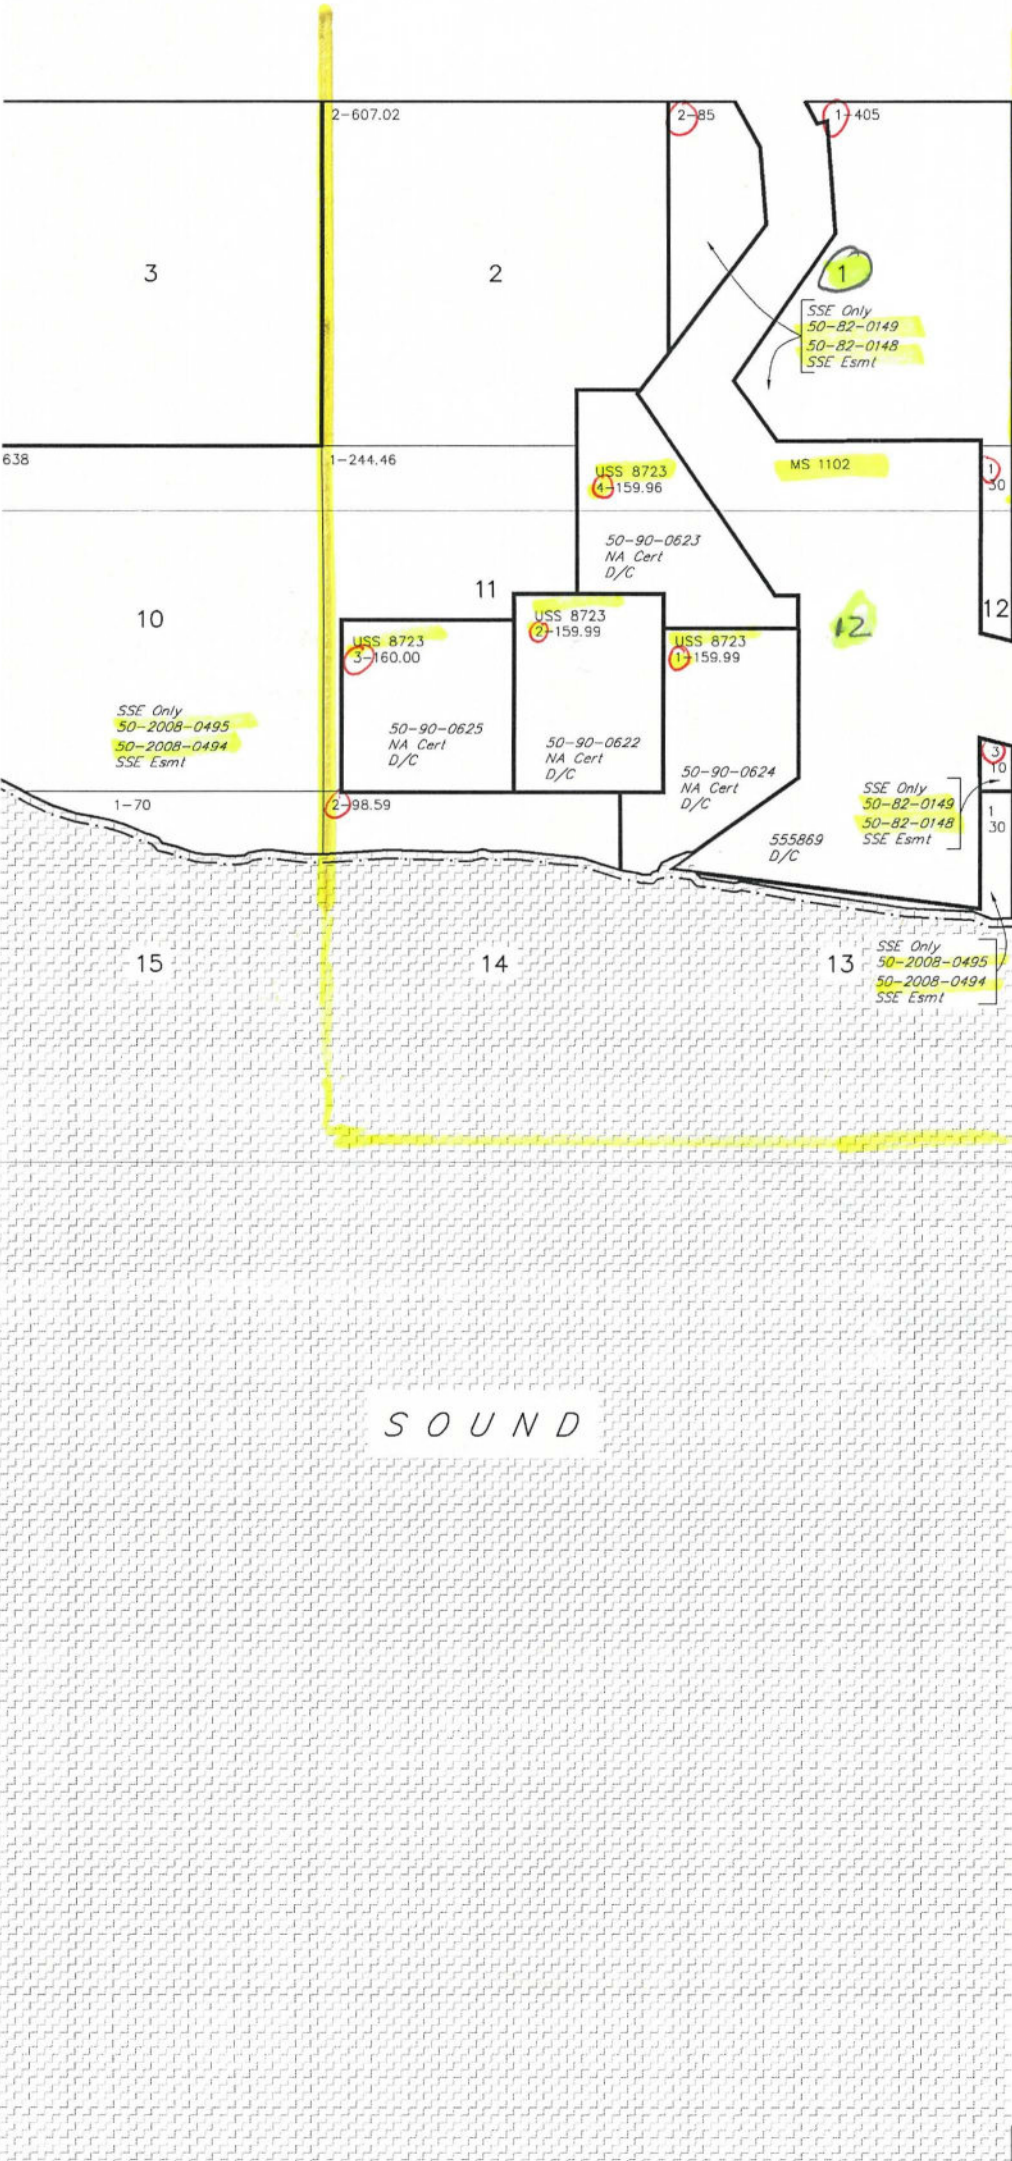

Patent (Sec 1, 12)

50-82-0148
 Sitnasuk Native Corp, Surface
 50-82-0149
 Bering Straits Native Corp, Sub-surface

Patent (Sec. 2, 11, 13, 14)

50-2008-0494
 Sitnasuk Native Corp, Surface
 50-2008-0495
 Bering Straits Native Corp, Subsurface

○ = Sections listed in unsigned 2014
 SITNASUK/AK GOLD EXPEDITIONS
 Temporary Access Esmt, Agmt

Sec. 1 only

SOUND



WARNING:
 This plot is the Bureau's Record of Title, and should be used only as a graphic display of the township survey data. Records hereon do not reflect title changes which may have been effected by lateral movements of rivers or other bodies of water. Refer to the cadastral surveys for official survey information.

CURRENT TO	
6-10-2010	

KR Mer
 T 11 S
 R 36 W

ACAD