


SURVEYED TOWNSHIP 11 SOUTH RANGE 37 WEST OF THE KATEEL RIVER MERIDIAN, ALASKA

Kine Island

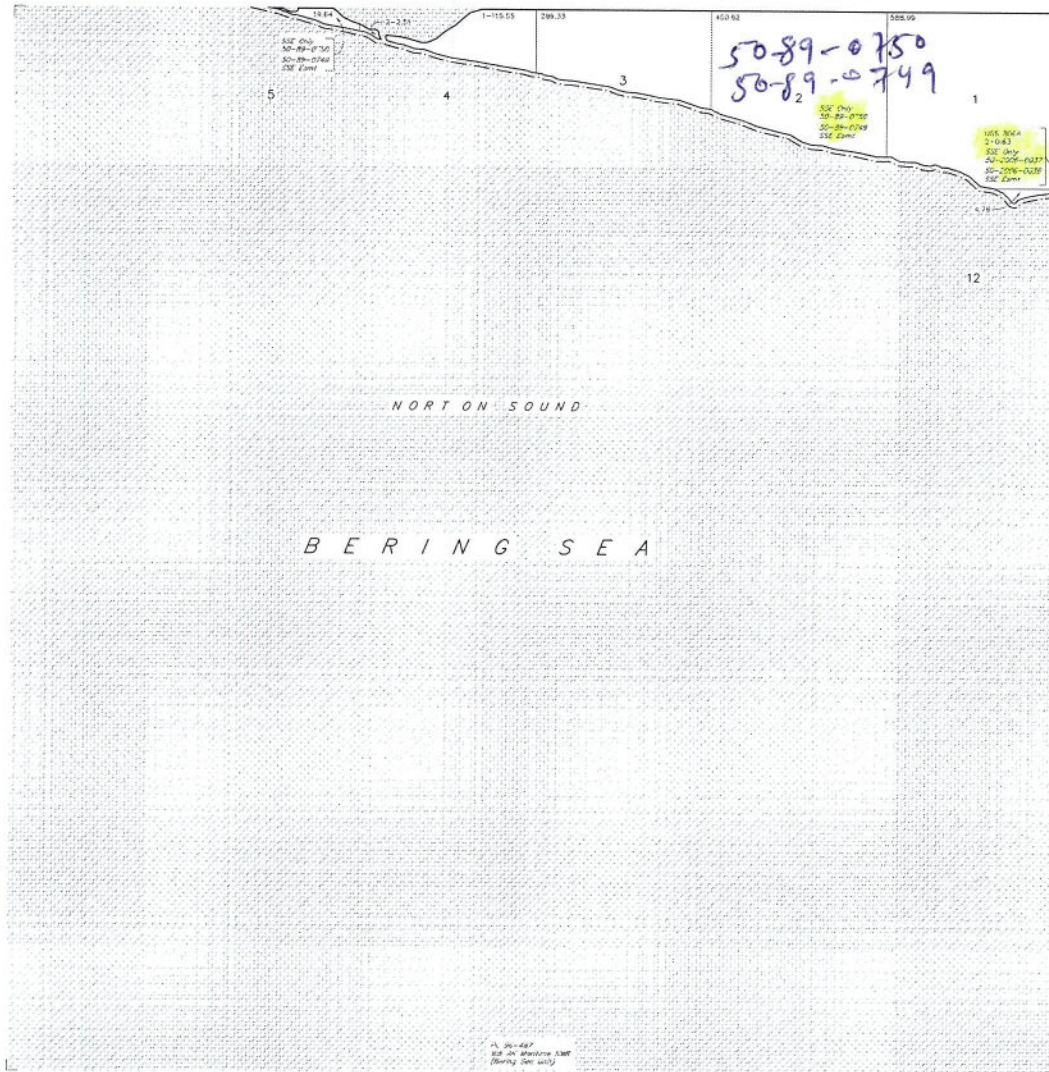

Lat 64°34'18.60"N
 Long 165°57'26.12"W

STATUS OF PUBLIC DOMAIN
 LAND AND MINERAL TITLES

MTP

FOR ORDERS EFFECTING DISPOSAL OR USE OF UN-
 IDENTIFIED LANDS WITHIN ANY FOR CLASSIFICATION
 MINERALS, WATER AND/OR OTHER PUBLIC PURPOSES
 REFER TO INDEX OF MISCELLANEOUS DOCUMENTS.

FOR MORE INFORMATION OR FOR OTHERS CONTACT THE BUREAU OF LAND MANAGEMENT

B E R I N G S E A

N O R T O N S O U N D


SCALE in chains
 0 10 20 30 40 50 60

NOTICE:
 This plat is the Bureau's Record of Title and should be used
 only as a guide. Errors of the township survey data, bear-
 ings and distances do not affect the plat. Errors which may have
 occurred in the original plat or in other copies of water
 plat to the landowner survey for official survey information.

CURRENT TO	KR Mer
12-5-2006	T 11 S
	R 37 W

ACAD

