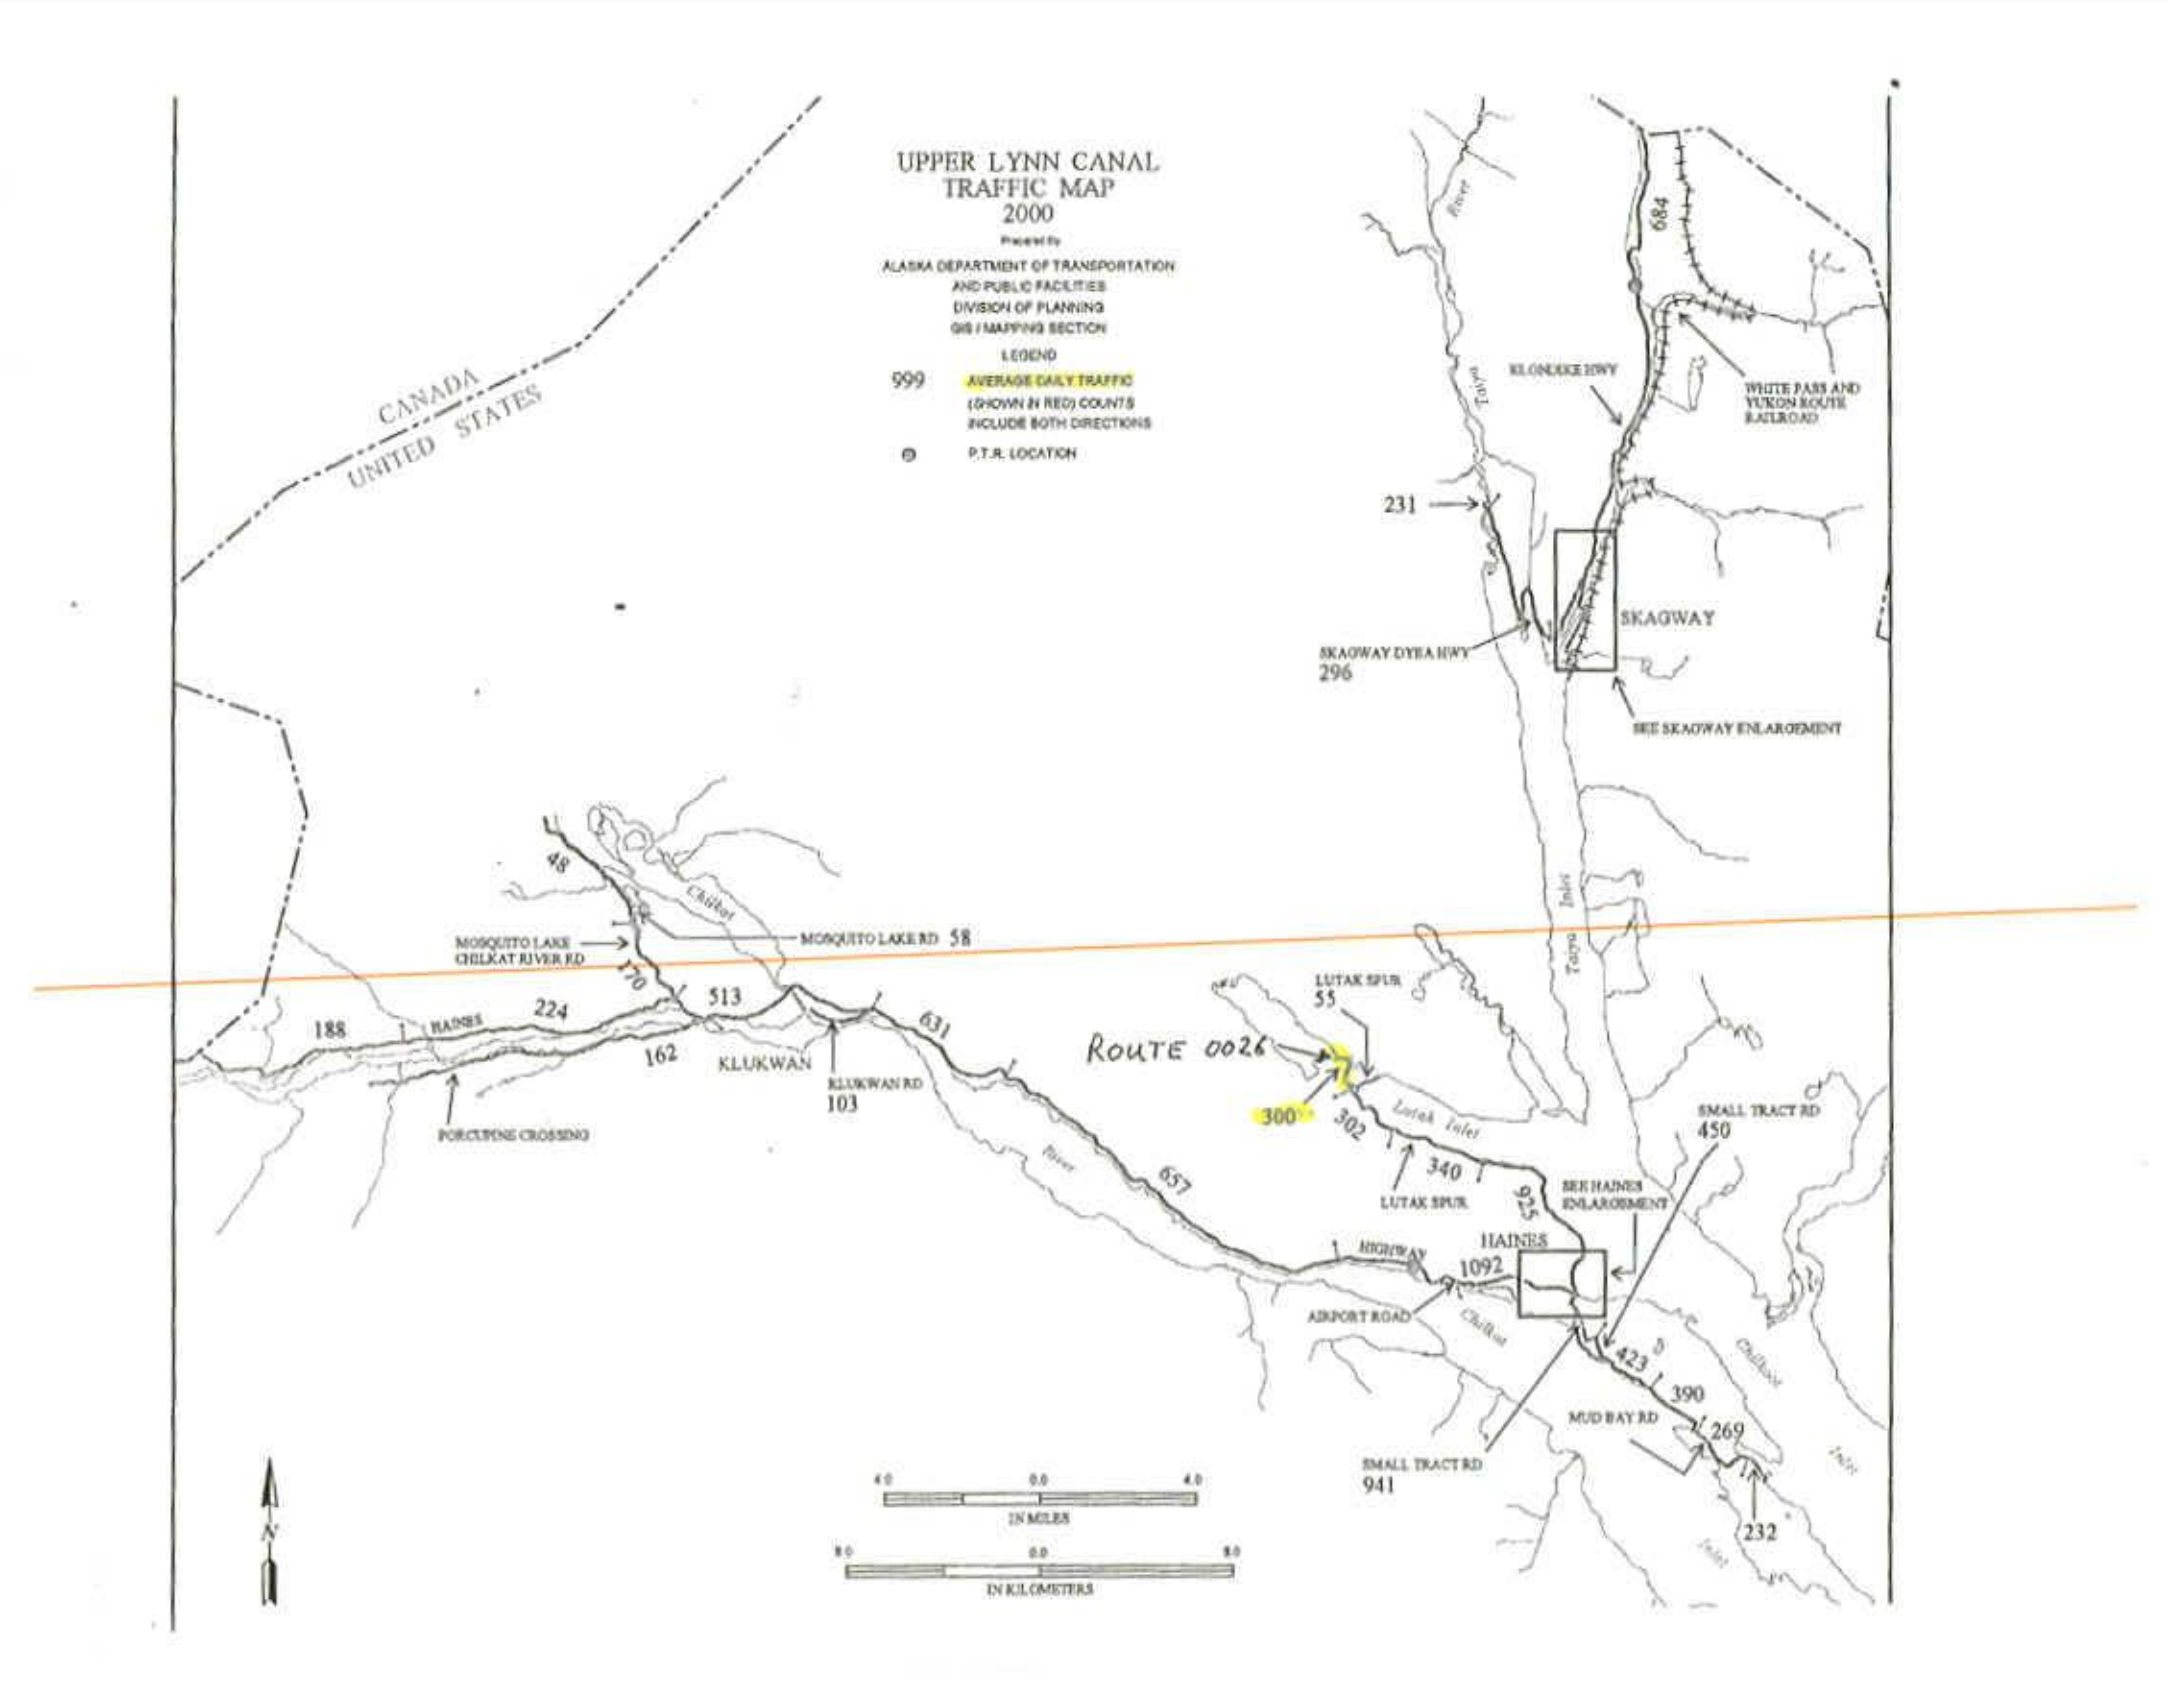
UPPER LYNN CANAL
TRAFFIC MAP
2000
Prepared by
ALASKA DEPARTMENT OF TRANSPORTATION
AND PUBLIC FACILITIES
DIVISION OF PLANNING
GIS / MAPPING SECTION
LEGEND
999 AVERAGE DAILY TRAFFIC (SHOWN IN RED) COUNTS INCLUDE BOTH DIRECTIONS
P.T.R. LOCATION
CANADA
UNITED STATES
684
KLONDIKE HWY
WHITE PASS AND YUKON ROUTE RAILROAD
231
SKAGWAY
SKAGWAY DYEA HWY
296
SEE SKAGWAY ENLARGEMENT
48
Chilkat
MOSQUITO LAKE
CHILKAT RIVER RD
MOSQUITO LAKE RD 58
170
513
188
HAINES
224
162
KLUKWAN
KLUKWAN RD
103
631
PORCUPINE CROSSING
ROUTE 0026
LUTAK SPUR
55
300
302
340
LUTAK SPUR
Lutak Inlet
SMALL TRACT RD
450
SEE HAINES ENLARGEMENT
925
657
HIGHWAY
HAINES
1092
AIRPORT ROAD
423
390
MUD BAY RD
269
SMALL TRACT RD
941
232
Taiya
Inlet
4.0 0.0 4.0
IN MILES
6.0 0.0 6.0
IN KILOMETERS
N