


Chilkoot Bridge Right-of-Way

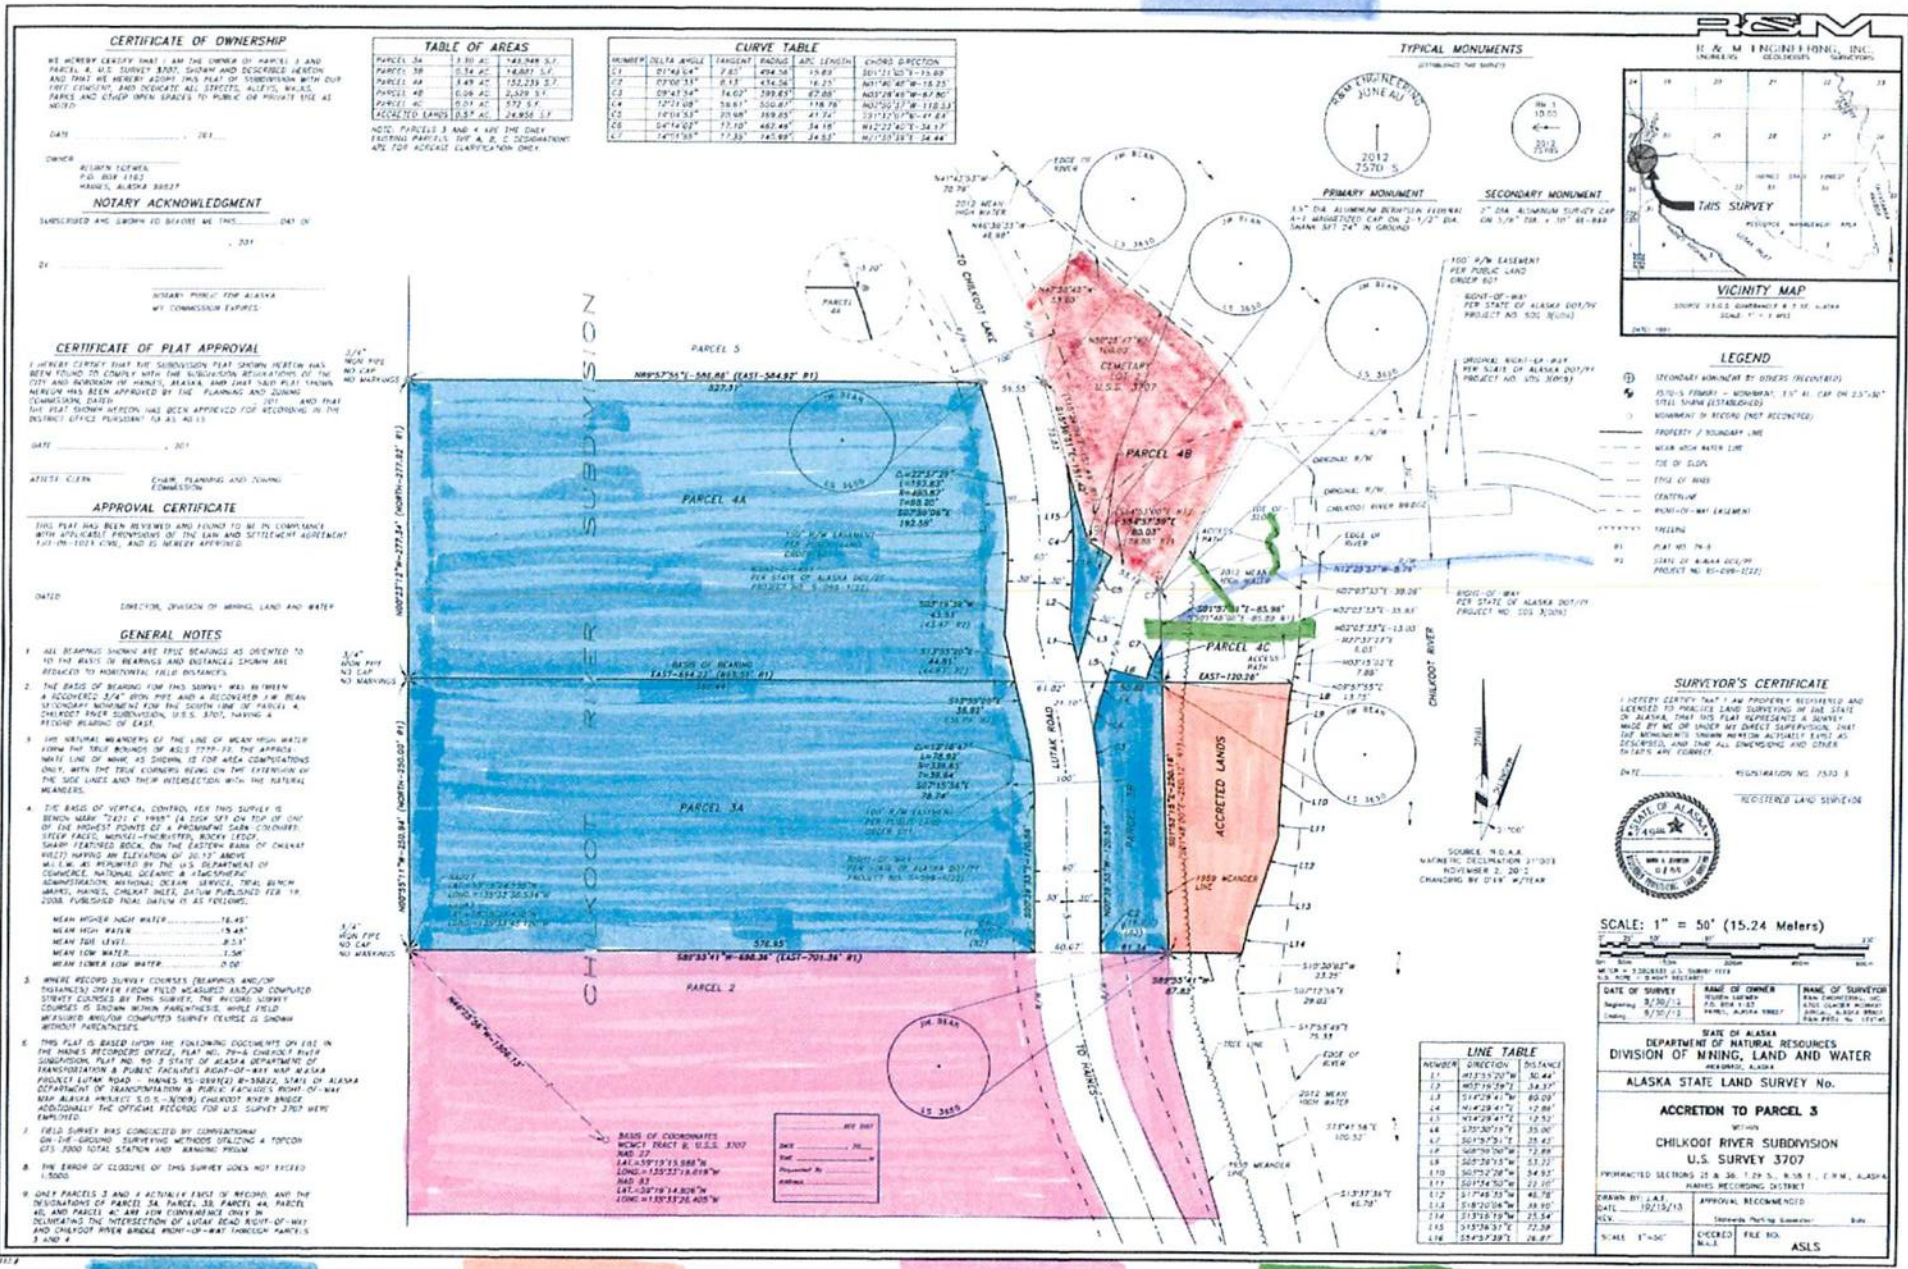

Loewen upland
Parcels 3 and 4

Accretions to
Parcel 3

Crupi Property

Access Paths

Lot 2, USS 3707