CORPS OF ENGINEERS

U. S. ARMY

ACQUISITION TRACT REGISTER

TRACT NO.	LAND OWNER	ACREAGE EASMT	ACREAGE LICENSE	REMARKS
A-115-E	Martin A. Cordes et ux	0.59		Perpetual R/W easement for P.O.L. pipeline from 10/7/54.
A-116-E	Allan MacKenzie et ux	0.52		" " " " " " 6/26/54.
A-117-E	Dorothy M. Fitzgerald	1.95		" " " " " " 6/22/54.
A-118-E	Ellen Allen McCoy et al	0.25		" " " " " " 12/7/55.
A-119-E	P. B. Allen et ux	1.03		" " " " " " 12/7/55.
A-120-E	Karl O. Comstock et ux	0.53		" " " " " " 6/22/54.
A-121-E	Forest J. Nowell et ux	0.35		" " " " " " 11/6/54, Civil No. 7183-A.
A-122-E	State of Alaska (Formerly Territory of Alaska)	1.36		Perpetual R/W easement for P.O.L. pipeline from 2/11/55, Civil No. 6965-A.
A-123-E	George Meacock et ux	1.10		Perpetual R/W easement for P.O.L. pipeline from 9/17/55.
A-124-E	Fred McRae et ux	0.26		" " " " " " 9/27/54.
A-125-E	Vance W. Phillips et ux	0.61		" " " " " " 11/6/54, Civil No. 7183-A.
C-201-E	Clarence Smith et al	0.07	X	Perpetual R/W easement for access road from 7/30/55, Civil No. 7341-A.
C-202-E	State of Alaska (Formerly Territory of Alaska)	0.93		Implied easement for access road from 26 July 1956
C-203-E	P. B. Allen et ux	0.19	X	Perpetual R/W easement for access road from 9/26/55.
C-204-E	John W. Lane Jr. et ux	0.93	X	" " " " " " 7/26/55.
C-205-L	Town of Haines		4.24 X	Letter dated 14 July 1955, effective 12 July 1955 for construction and maintenance of access road.
C-206-E	Catherine Polley	0.01	X	Perpetual R/W easement for access road from 7/30/55, Civil No. 7341-A.
C-207-E	I. B. Howser et ux	0.11	X	Perpetual R/W easement for access road from 7/18/55.
C-117-E	State of Alaska (Dept. Hwy			Entire Strip 0.11 ac incl in Tr C-207-E. Reacquired by Purchase at Release 4th Amdt.

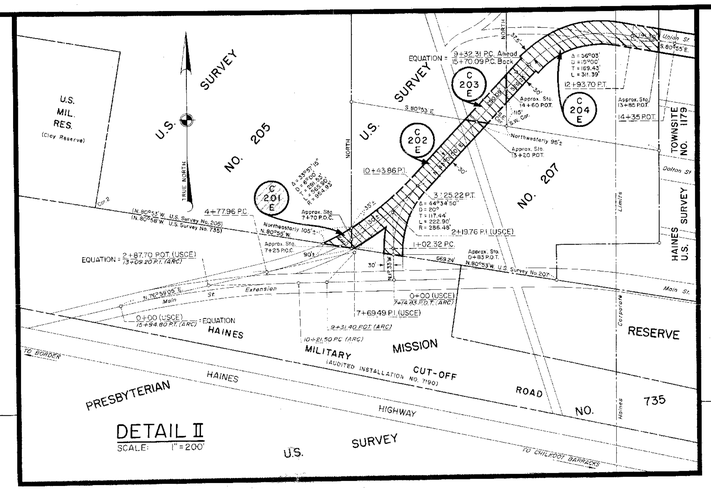

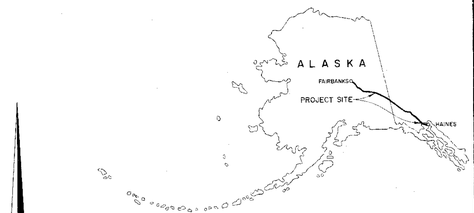

STATE INDEX

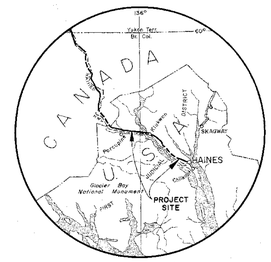

VICINITY MAP

SCALE IN MILES

NOTE:
This drawing is based on the official G.L.O. Township Plat for T.30 S., R.39 E., C.R.M. dated 6 May 1922, Real Estate Drawing No. A1-24-4.2, Sheet 2 of 2, revised 9 October 1955, Drawing No. 78-15-06 and information furnished by the using agency.

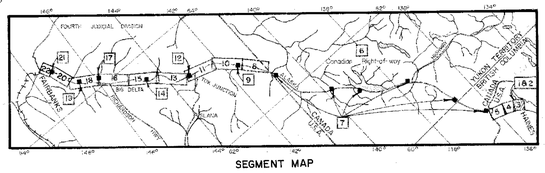

SEGMENT MAP

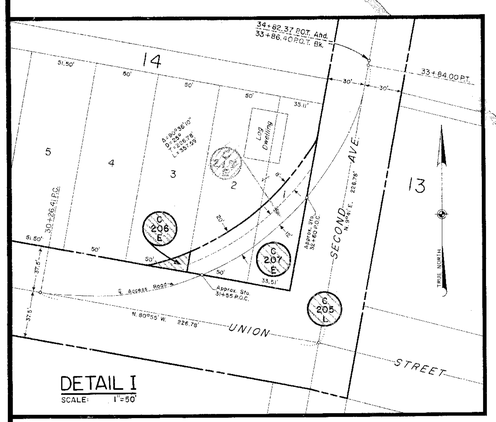

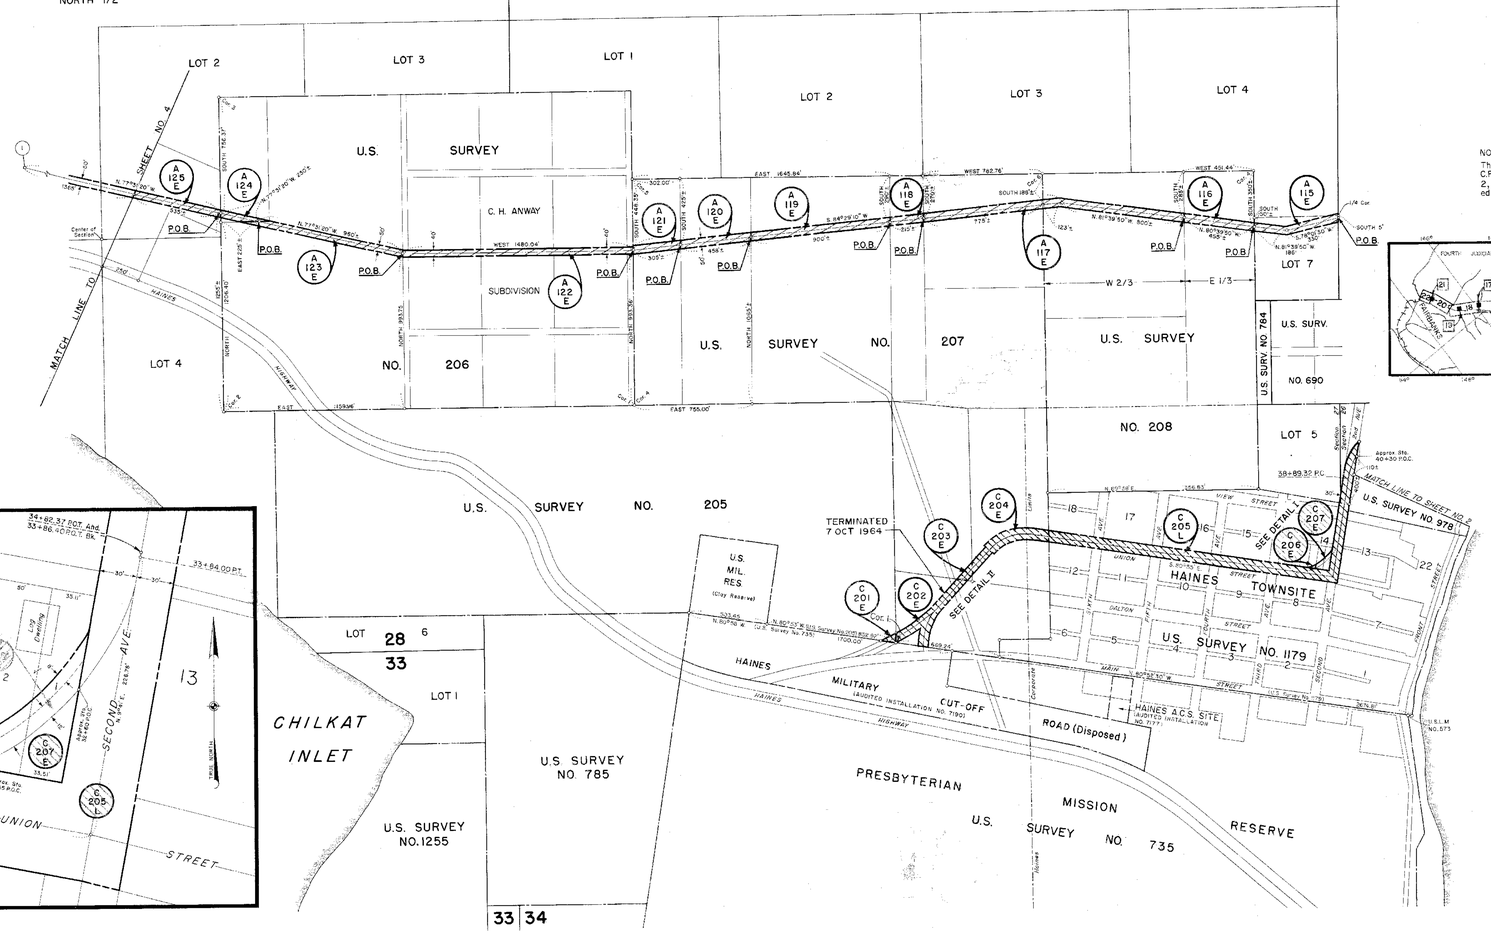

FINAL PROJECT MAP

DEPT. OF THE: ARMY

USING SERVICE: USARAL

LOCATION OF PROJECT

STATE: ALASKA

STATE JUDICIAL DISTRICT: FIRST

DIVISION: NORTH PACIFIC

DISTRICT: ALASKA

ALASKAN COMMAND

AT ~~MILES~~ ~~OF~~ HAINES

~~MILES~~ OF

TRANSPORTATION FACILITIES

RAILROADS

STATE ROADS: HAINES HIGHWAY

FEDERAL ROADS

AIR LINES: ALASKA AIRLINES

ACQUISITION

TOTAL ACRES ACQUIRED

FEE

PUBLIC DOMAIN: PERM. WITHDRAWAL / TEMP. WITHDRAWAL

USE PERMIT

TRANSFER: SEE SHEET NO. 1

LEASE

LESSER INTERESTS

DISPOSAL

TOTAL ACRES DISPOSED OF

SOLD

PUBLIC DOMAIN: PERM. WITHDRAWAL / TEMP. WITHDRAWAL

USE PERMIT

TRANSFERRED: SEE SHEET NO. 1

LEASES TERMINATED

LESSER INTERESTS TERM.

REASSIGNED

OTHER

ACQUISITION AUTHORIZATION

RE-D 5561 DATED 14 NOV 1952

RE-D 5732A DATED 25 APR 1955

LEGEND

EXCEPT FOR THE SPECIAL SYMBOLS SHOWN BELOW MAP SYMBOLS ARE STANDARD IN ARMY MAP SERVICE TECHNICAL MANUAL NO. 23.

RESERVATION LINE

RESERVATION LINE (Actual Survey)

TRACT BOUNDARY LINE

TRACT NUMBER

CONTOUR LINE

DISPOSAL

5.55 ACRES CONVEYED TO STATE OF ALASKA, DEPT. OF HIGHWAYS, BY QUITCLAIM DEED DTD. 7 OCT 1964 (TRACTS C-201E, C-203E, C-204E, C-205L, C-206E, C-207E). (REACQUIRED QCD SEE TR. C-207E)

35.83 ACRES FEE BY QCD DTD 17 APR 1984 TO PREVIOUS OWNERS. (8.55 ACRESTHIS SHEET.) TRACTS A-115E, A-116E, A-117E, A-118E, A-119E, A-120E, A-121E, A-122E, A-123E A-124E AND A-125E.

DATE	REVISIONS	BY
31Jan1991	Disposal Notation for Tr. A-115E thru A-125E added.	RLC
30 Apr 69	Due to Final Audit	R.D.

DEPARTMENT OF THE ARMY
OFFICE OF THE ALASKA DISTRICT ENGINEER
NORTH PACIFIC DIVISION

DRAWN BY: V.C.E.
TRACED BY: L.H.P.
CHECKED BY: P.M.G.

SUBMITTED BY: Vernon E. Cruikshank
CHIEF, PLNG & CONTROL BR.

RECOMMENDED BY: Samuel L. Austin
CHIEF, REAL ESTATE DIV.

APPROVED BY: [signature] DISTRICT ENGINEER DATE 2 APR 92

REAL ESTATE
ALASKAN PETROLEUM PIPELINE SYSTEM
HAINES - FAIRBANKS DIVISION
MILITARY RESERVATION

OFFICE, CHIEF OF ENGINEERS, WASHINGTON 25, D. C.

AUDITED

INSTALLATION OR PROJECT NO. GI-1-0006

Scale in Feet 1"=400'

SHEET 3 OF 22 DRAWING NO. AA-77 3

ENG FORM 1456-a
25 MAR 57