


SUBDIVISION  
OF  
RICKERT HOMESTEAD

U.S. Sur. No. 849  
Entry No. 0330  
Pat. No. 578146  
T.S. By G. Karapetukoff  
SCALE 1"=100'  
REVISED 12-11-43

T 1 S  
R 1 W  
SEC 10  
SEC 15

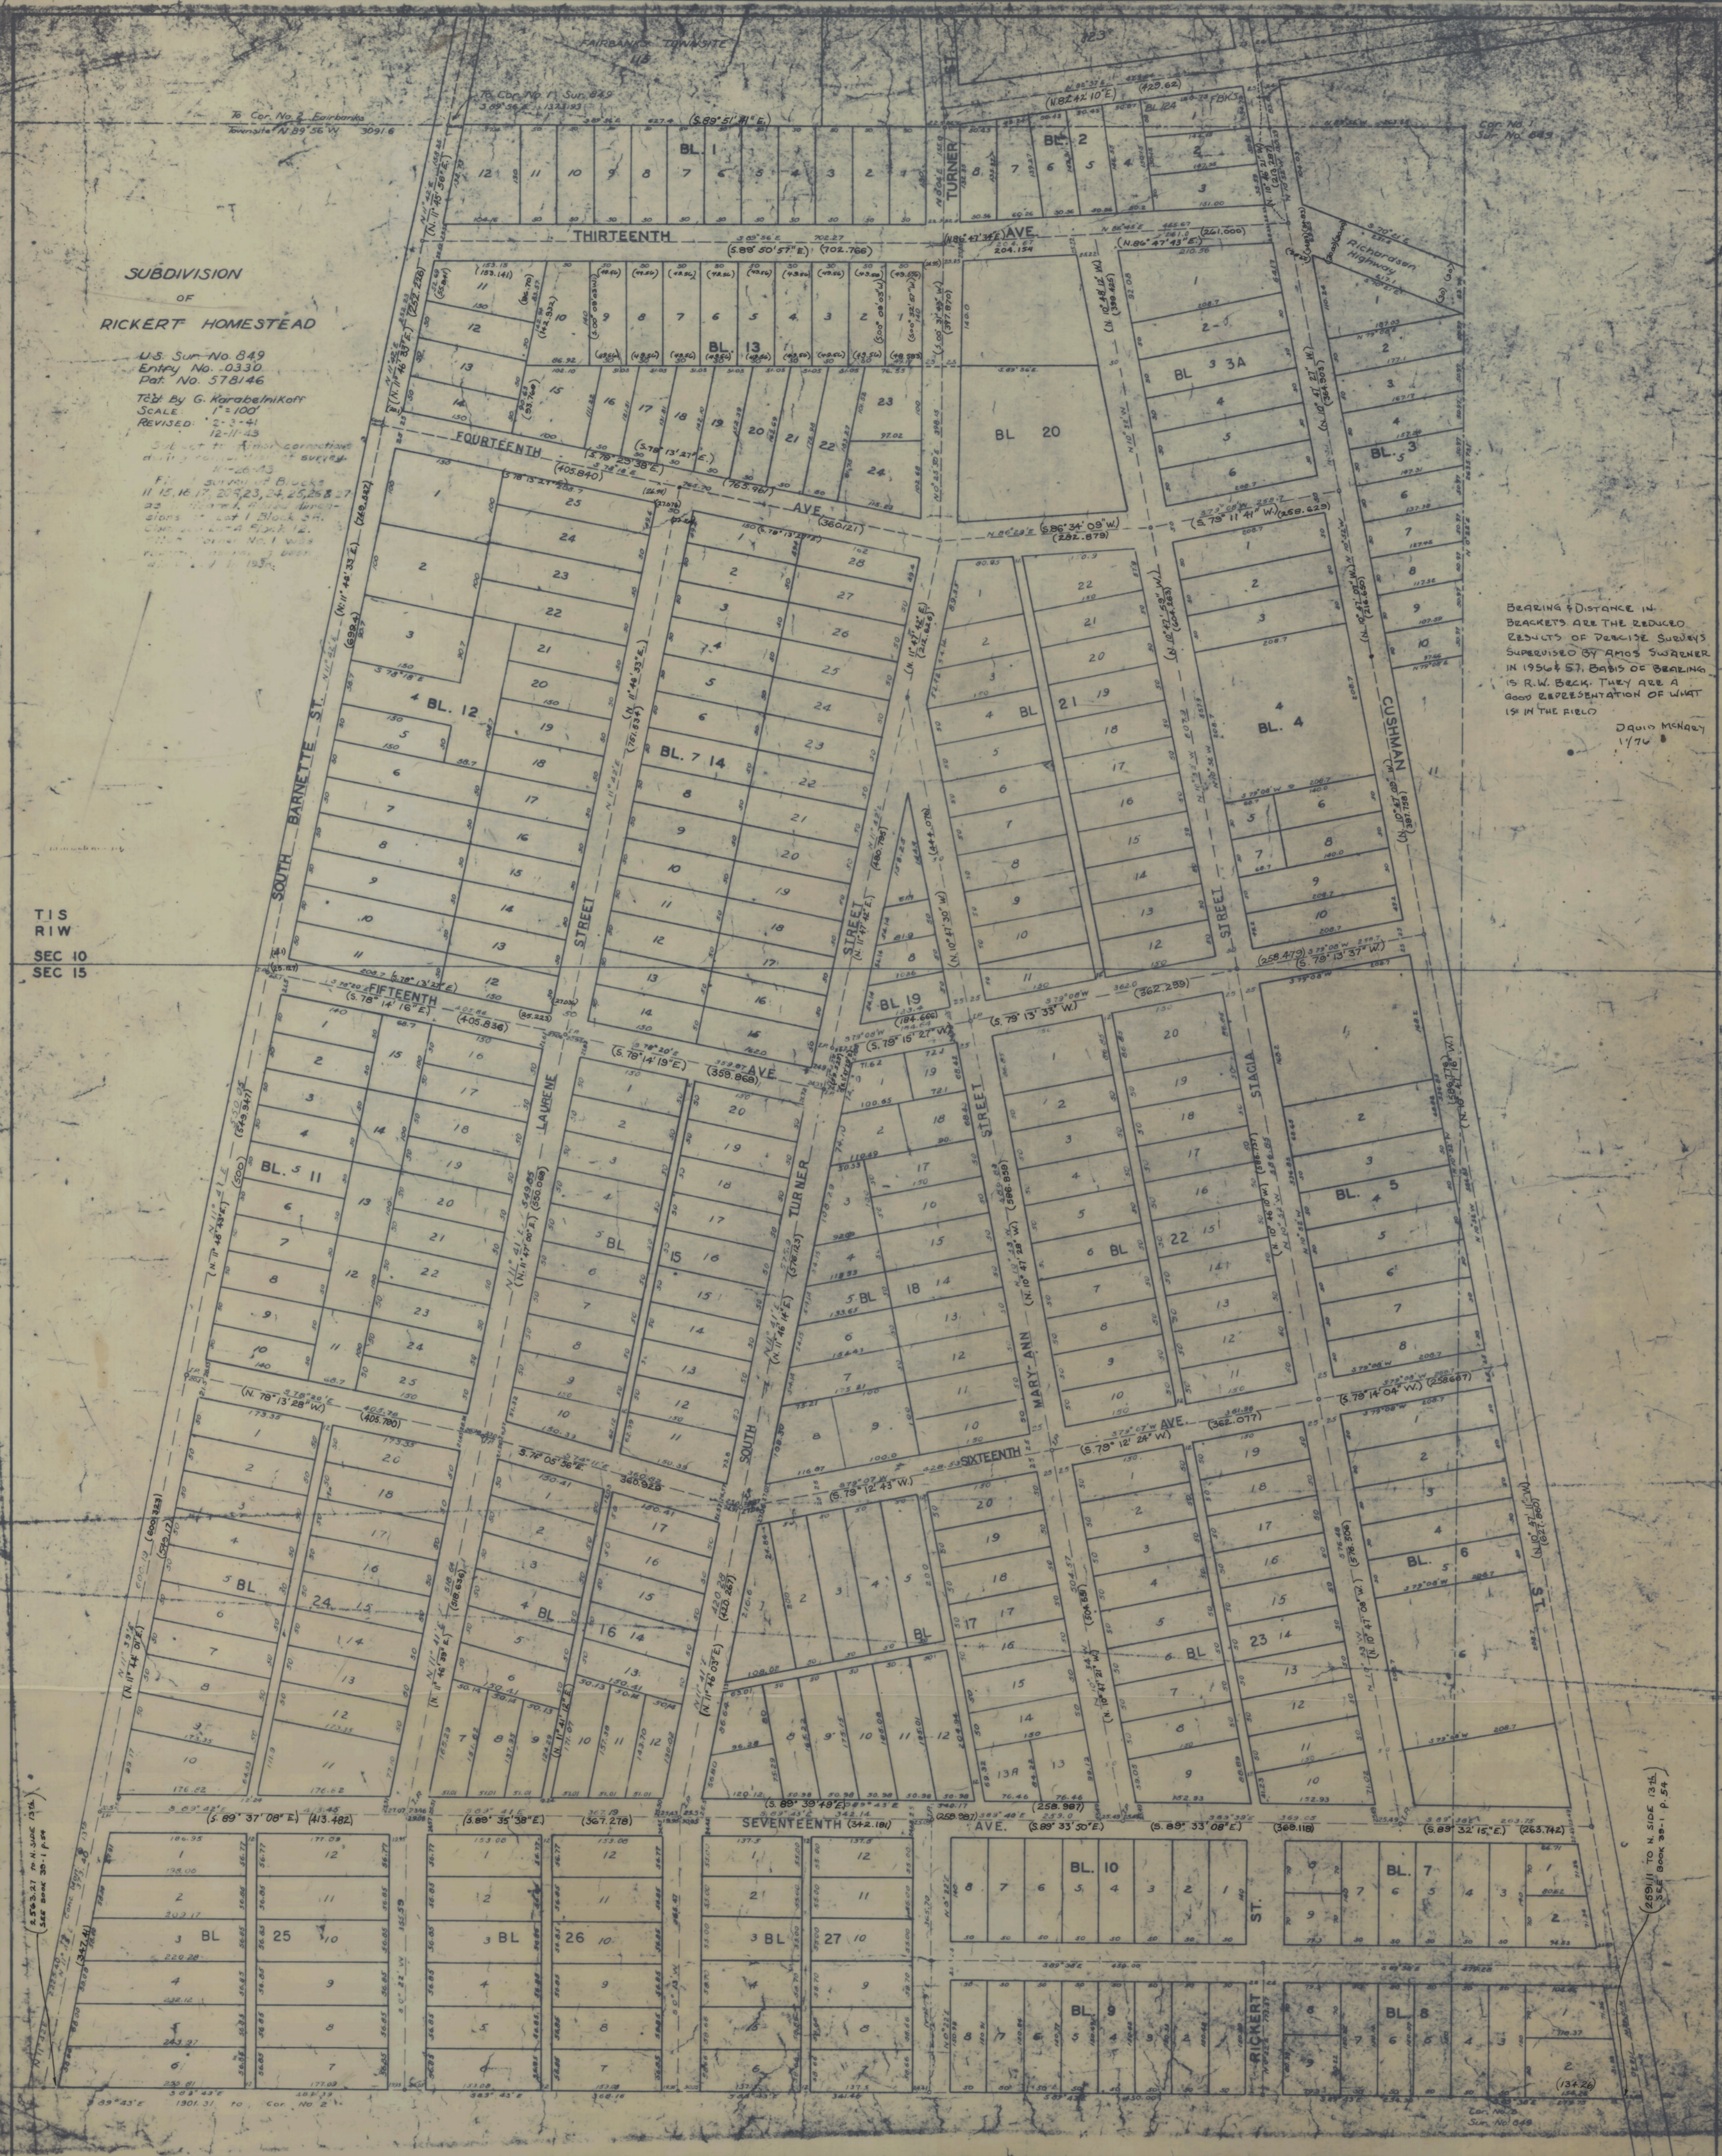

BEARINGS & DISTANCE IN  
BRACKETS ARE THE REDUCED  
RESULTS OF PERMITS SURVEYS  
SUPERVISED BY AMOS SWENNER  
IN 1954 & 57. BASIS OF BEARING  
& R.W. BECK. THEY ARE A  
GOOD REPRESENTATION OF WHAT  
IS IN THE FIELD.  
Dwight McNeely  
1/7/68

(SEE) SEE SIDE OF PLAT  
FOR