


STATE	PROJECT DELIVERABLES
ALASKA	F-062-4(27) F-037-1.27
	70 18 106

Concrete Removal

Station	Lt/E	Rt	Sdwk.	Pav.
166+62	X	X		108' E
165+92	X	X	0	18
166+22	X	X	225	2
166+33	X	X	2	727
166+26	X	X	26	2
167+69	X	X	2	116
168+34	X	X	2	116
168+97	X	X	2	358
Total's			6951	12173x

- ① Remove 41ft. of C66
- ② Remove 59ft. of C66
- ③ Remove 134ft. of C66
- ④ Remove 112ft. of C66

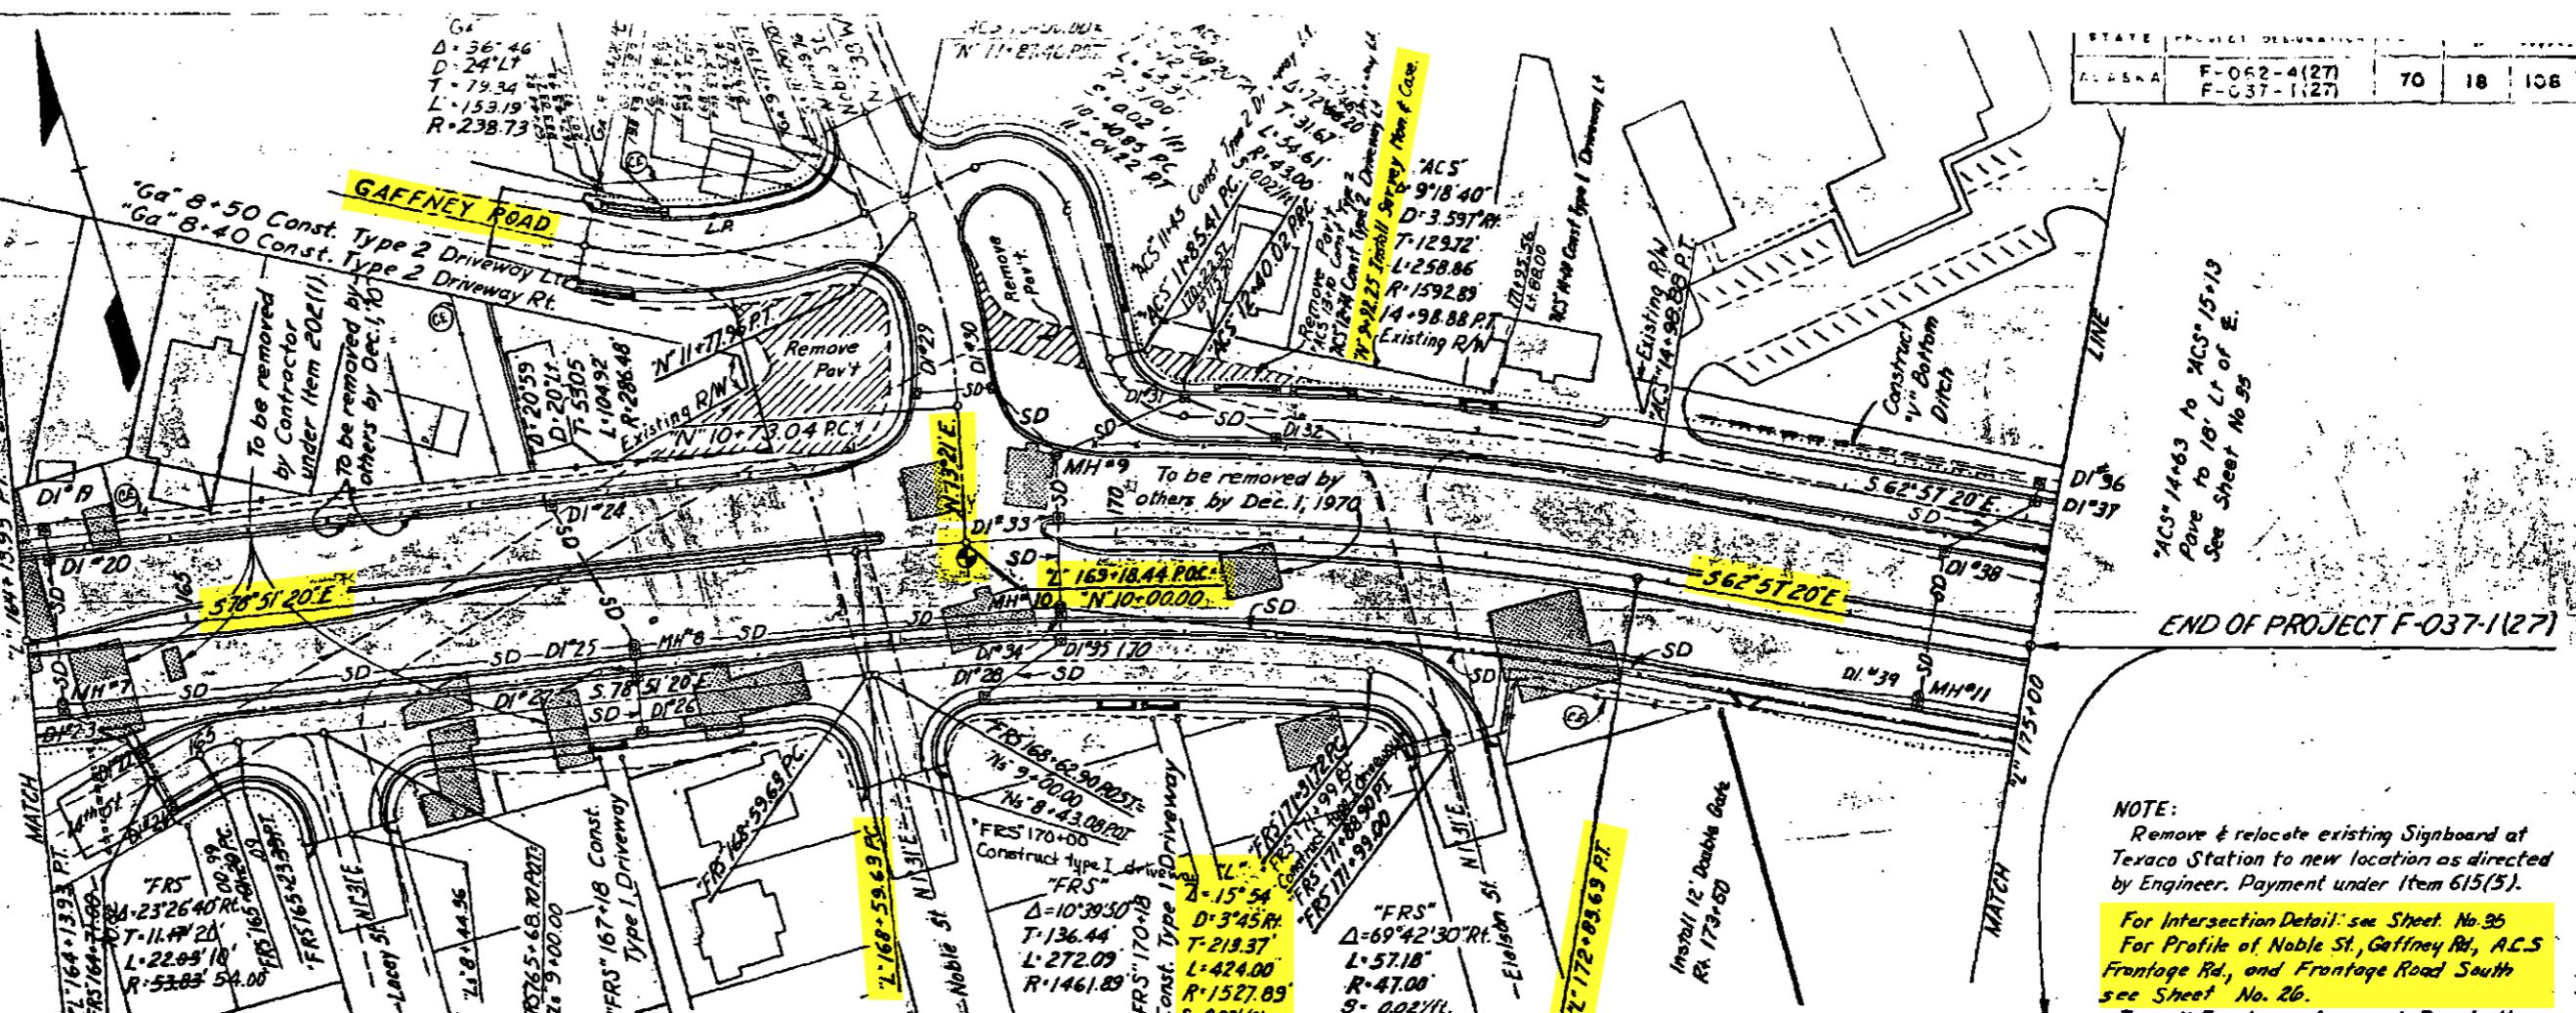

END OF PROJECT F-037-1.27

NOTE:
Remove & relocate existing Signboard at Texaco Station to new location as directed by Engineer. Payment under Item 615(5).

For Intersection Detail see Sheet No 36
For Profile of Noble St., Gaffney Rd., ACS
Frontage Rd., and Frontage Road South
see Sheet No. 26.

For all Frontage Approach Roads the radius shall be 35' to the edge of the travelled lane unless otherwise noted.

