
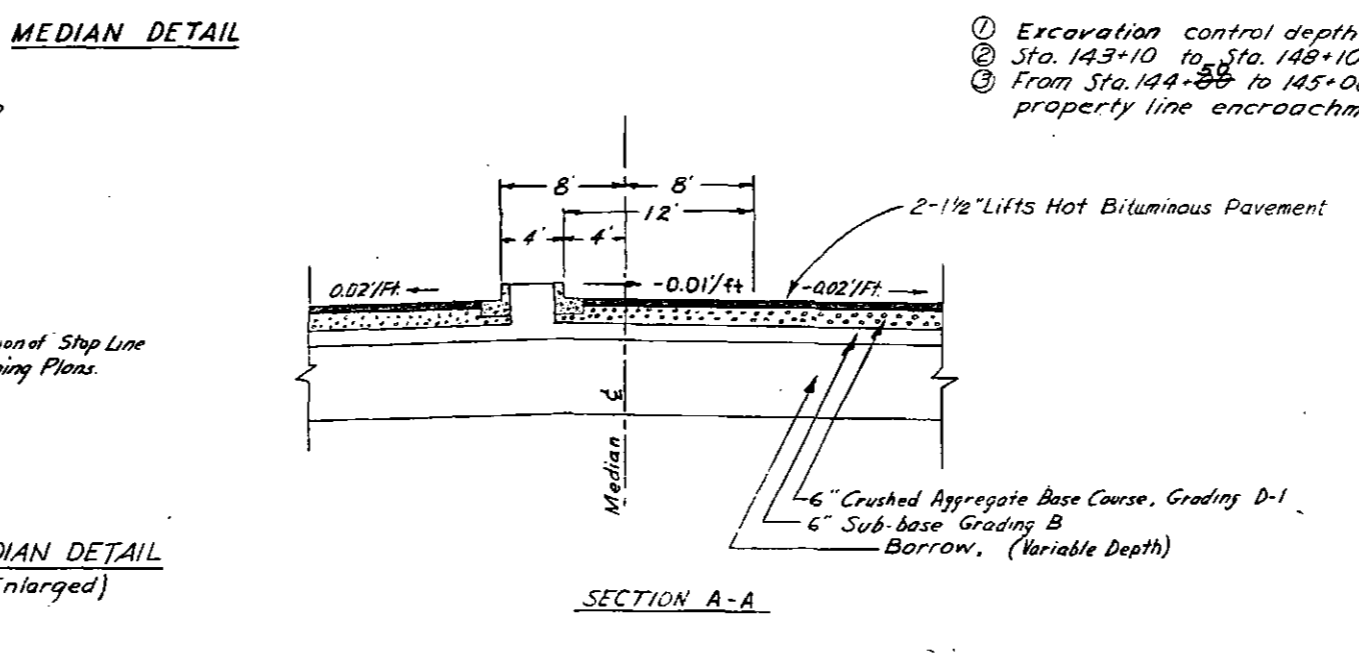
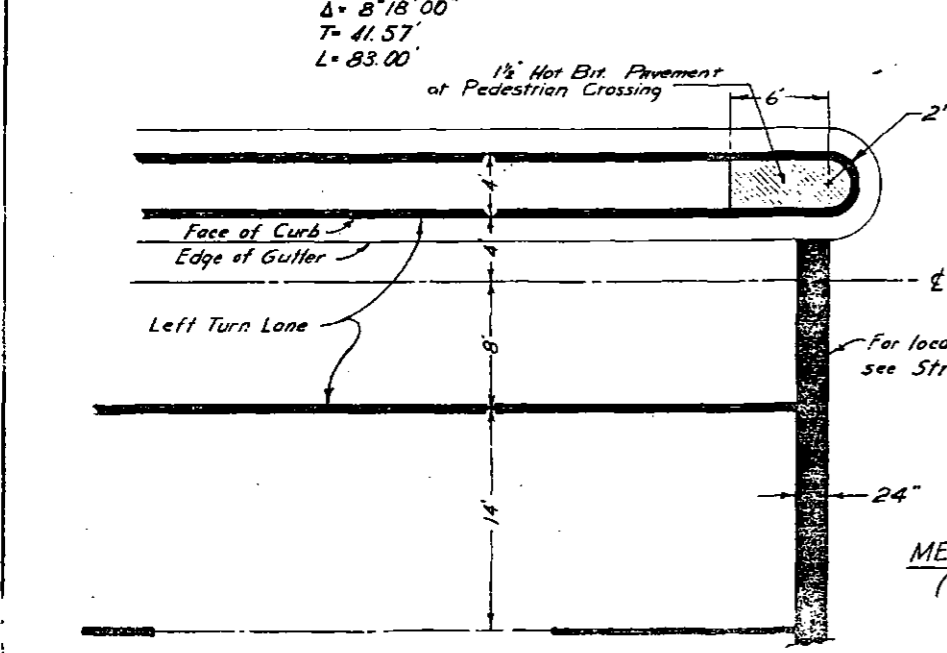
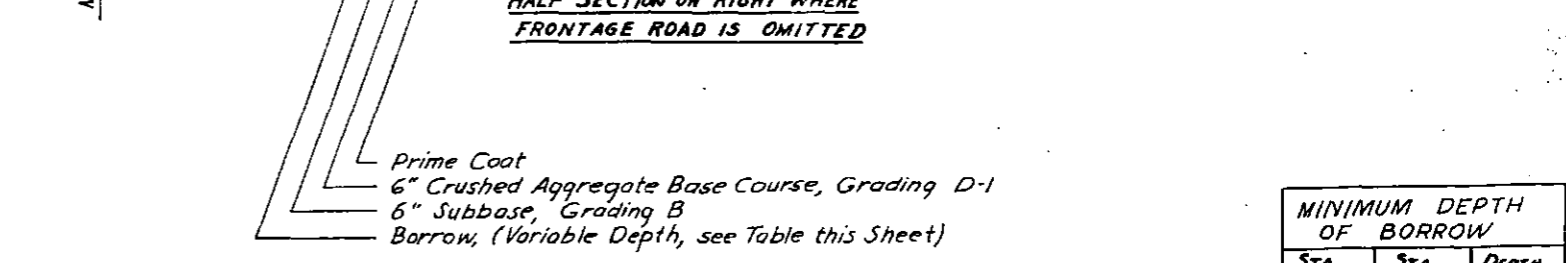
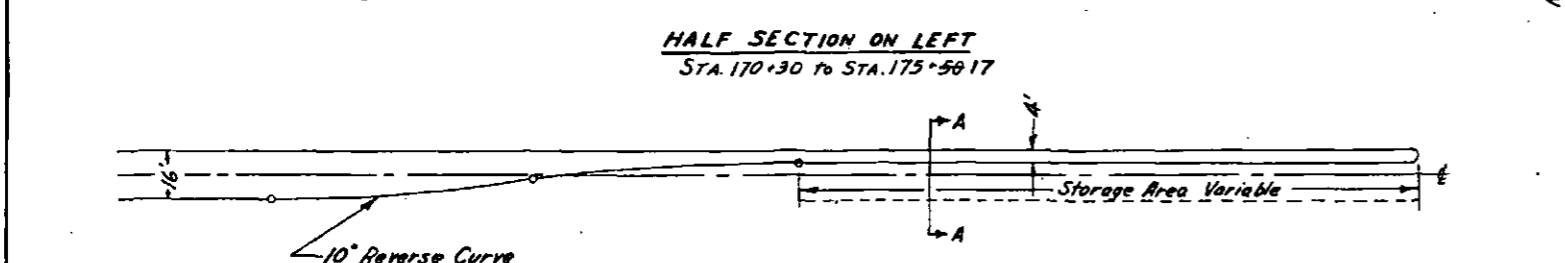
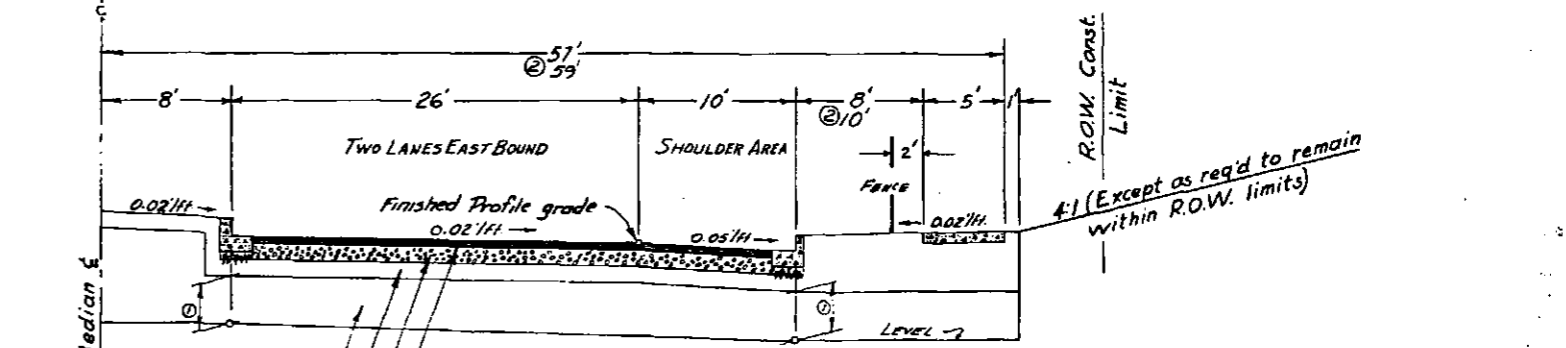
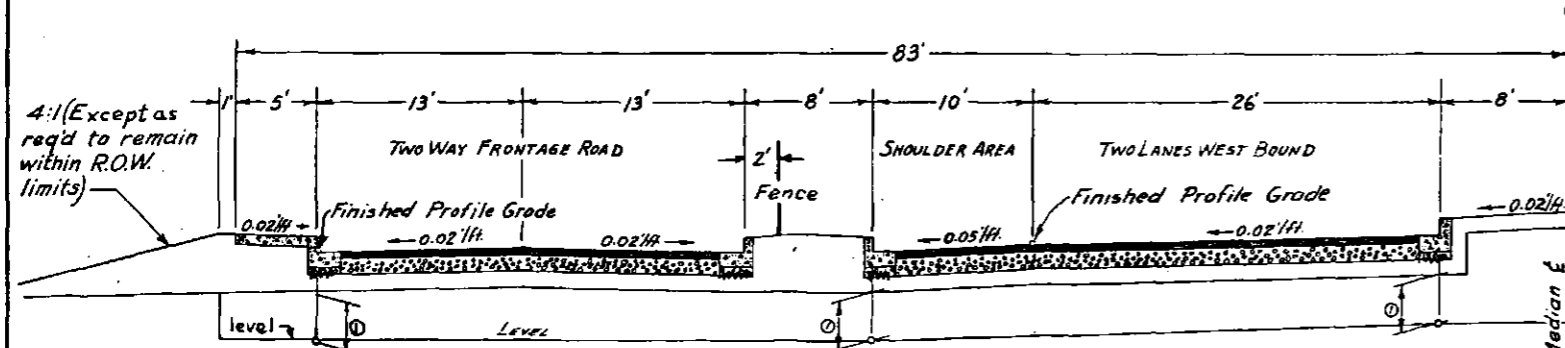


TYPICAL SECTION

NO.	DATE	BY	CHKD	APP'D
F-002-4(27)	70	2	108	

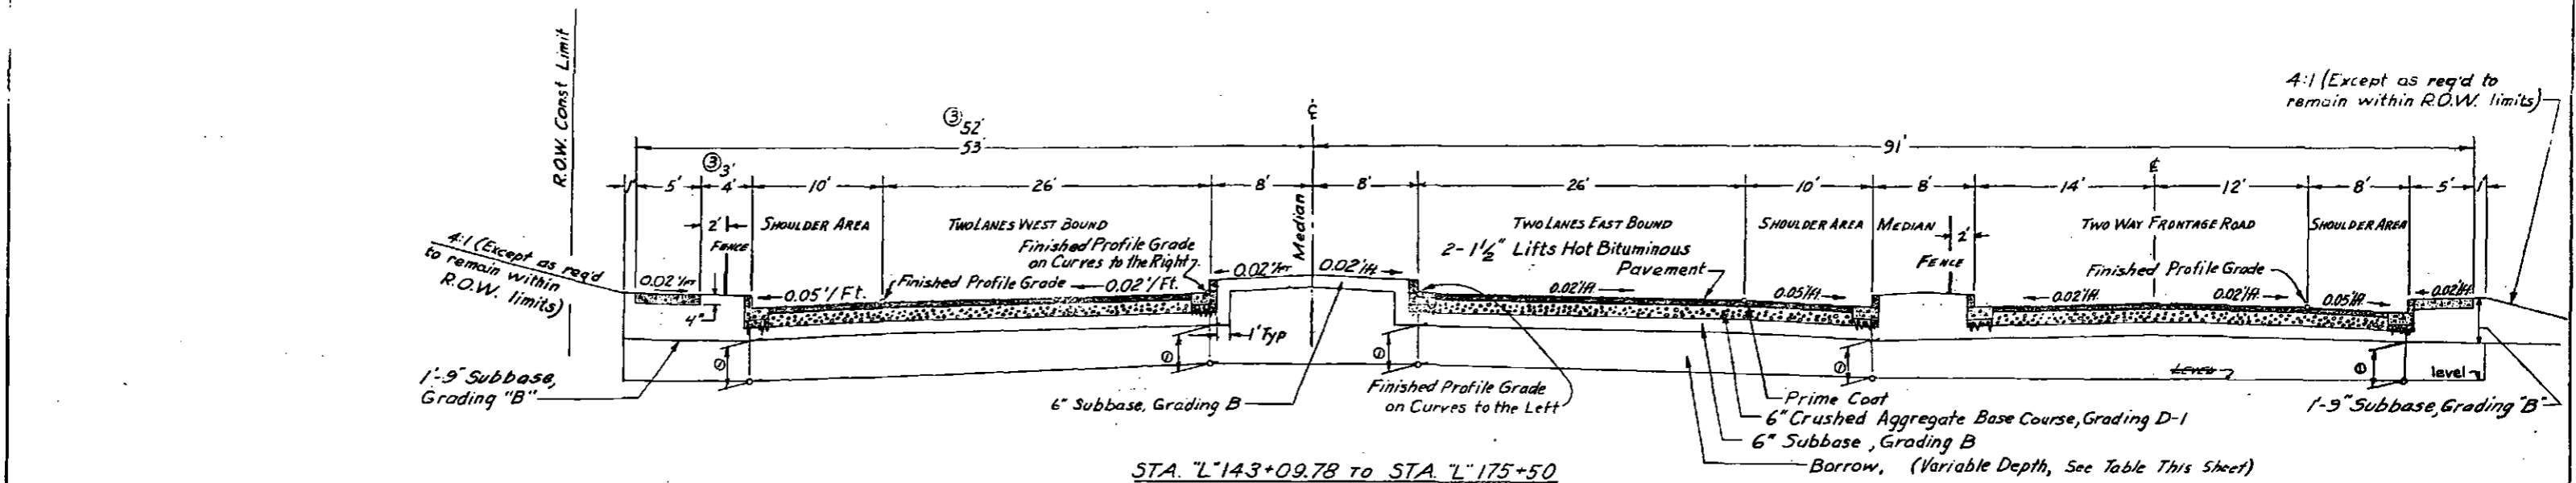

- ① Excavation control depth (See Table)
- ② Sta. 143+10 to Sta. 148+10
- ③ From Sta. 144+50 to 145+00 Lt. to avoid property line encroachment.

STA	STA	DEPTH
143+09	156+50	30"
156+50	176+00	36"
176+00	184+50	60"
184+50	187+22	30"

For General Notes see Sheet No. 16

Item	Quantity
Subbase, Grading "B"	1.90 tons/Cubic Yard
Hot Bituminous Pavement	112 ^m per Sq Yd.-in.
MC-30 Prime Coat	0.20 gal./Sq Yd. or 0.000086 T./Sq Ft.
Borrow	1.90 tons/Cubic Yard
Crushed Aggregate Base Course	145 ^m per Cubic Foot
Watering	10 M Gallons per Station from "L"0+23 to "L"66+54
Watering	25 M Gallons per Station from "L"143+10 to "L"187+22

105 2-24-70
