


TOWNSHIPS 21 TO 24 SOUTH, RANGES 22 TO 25 EAST, COPPER RIVER MERIDIAN, ALASKA

EXTRACTED FROM SURVEY MAP

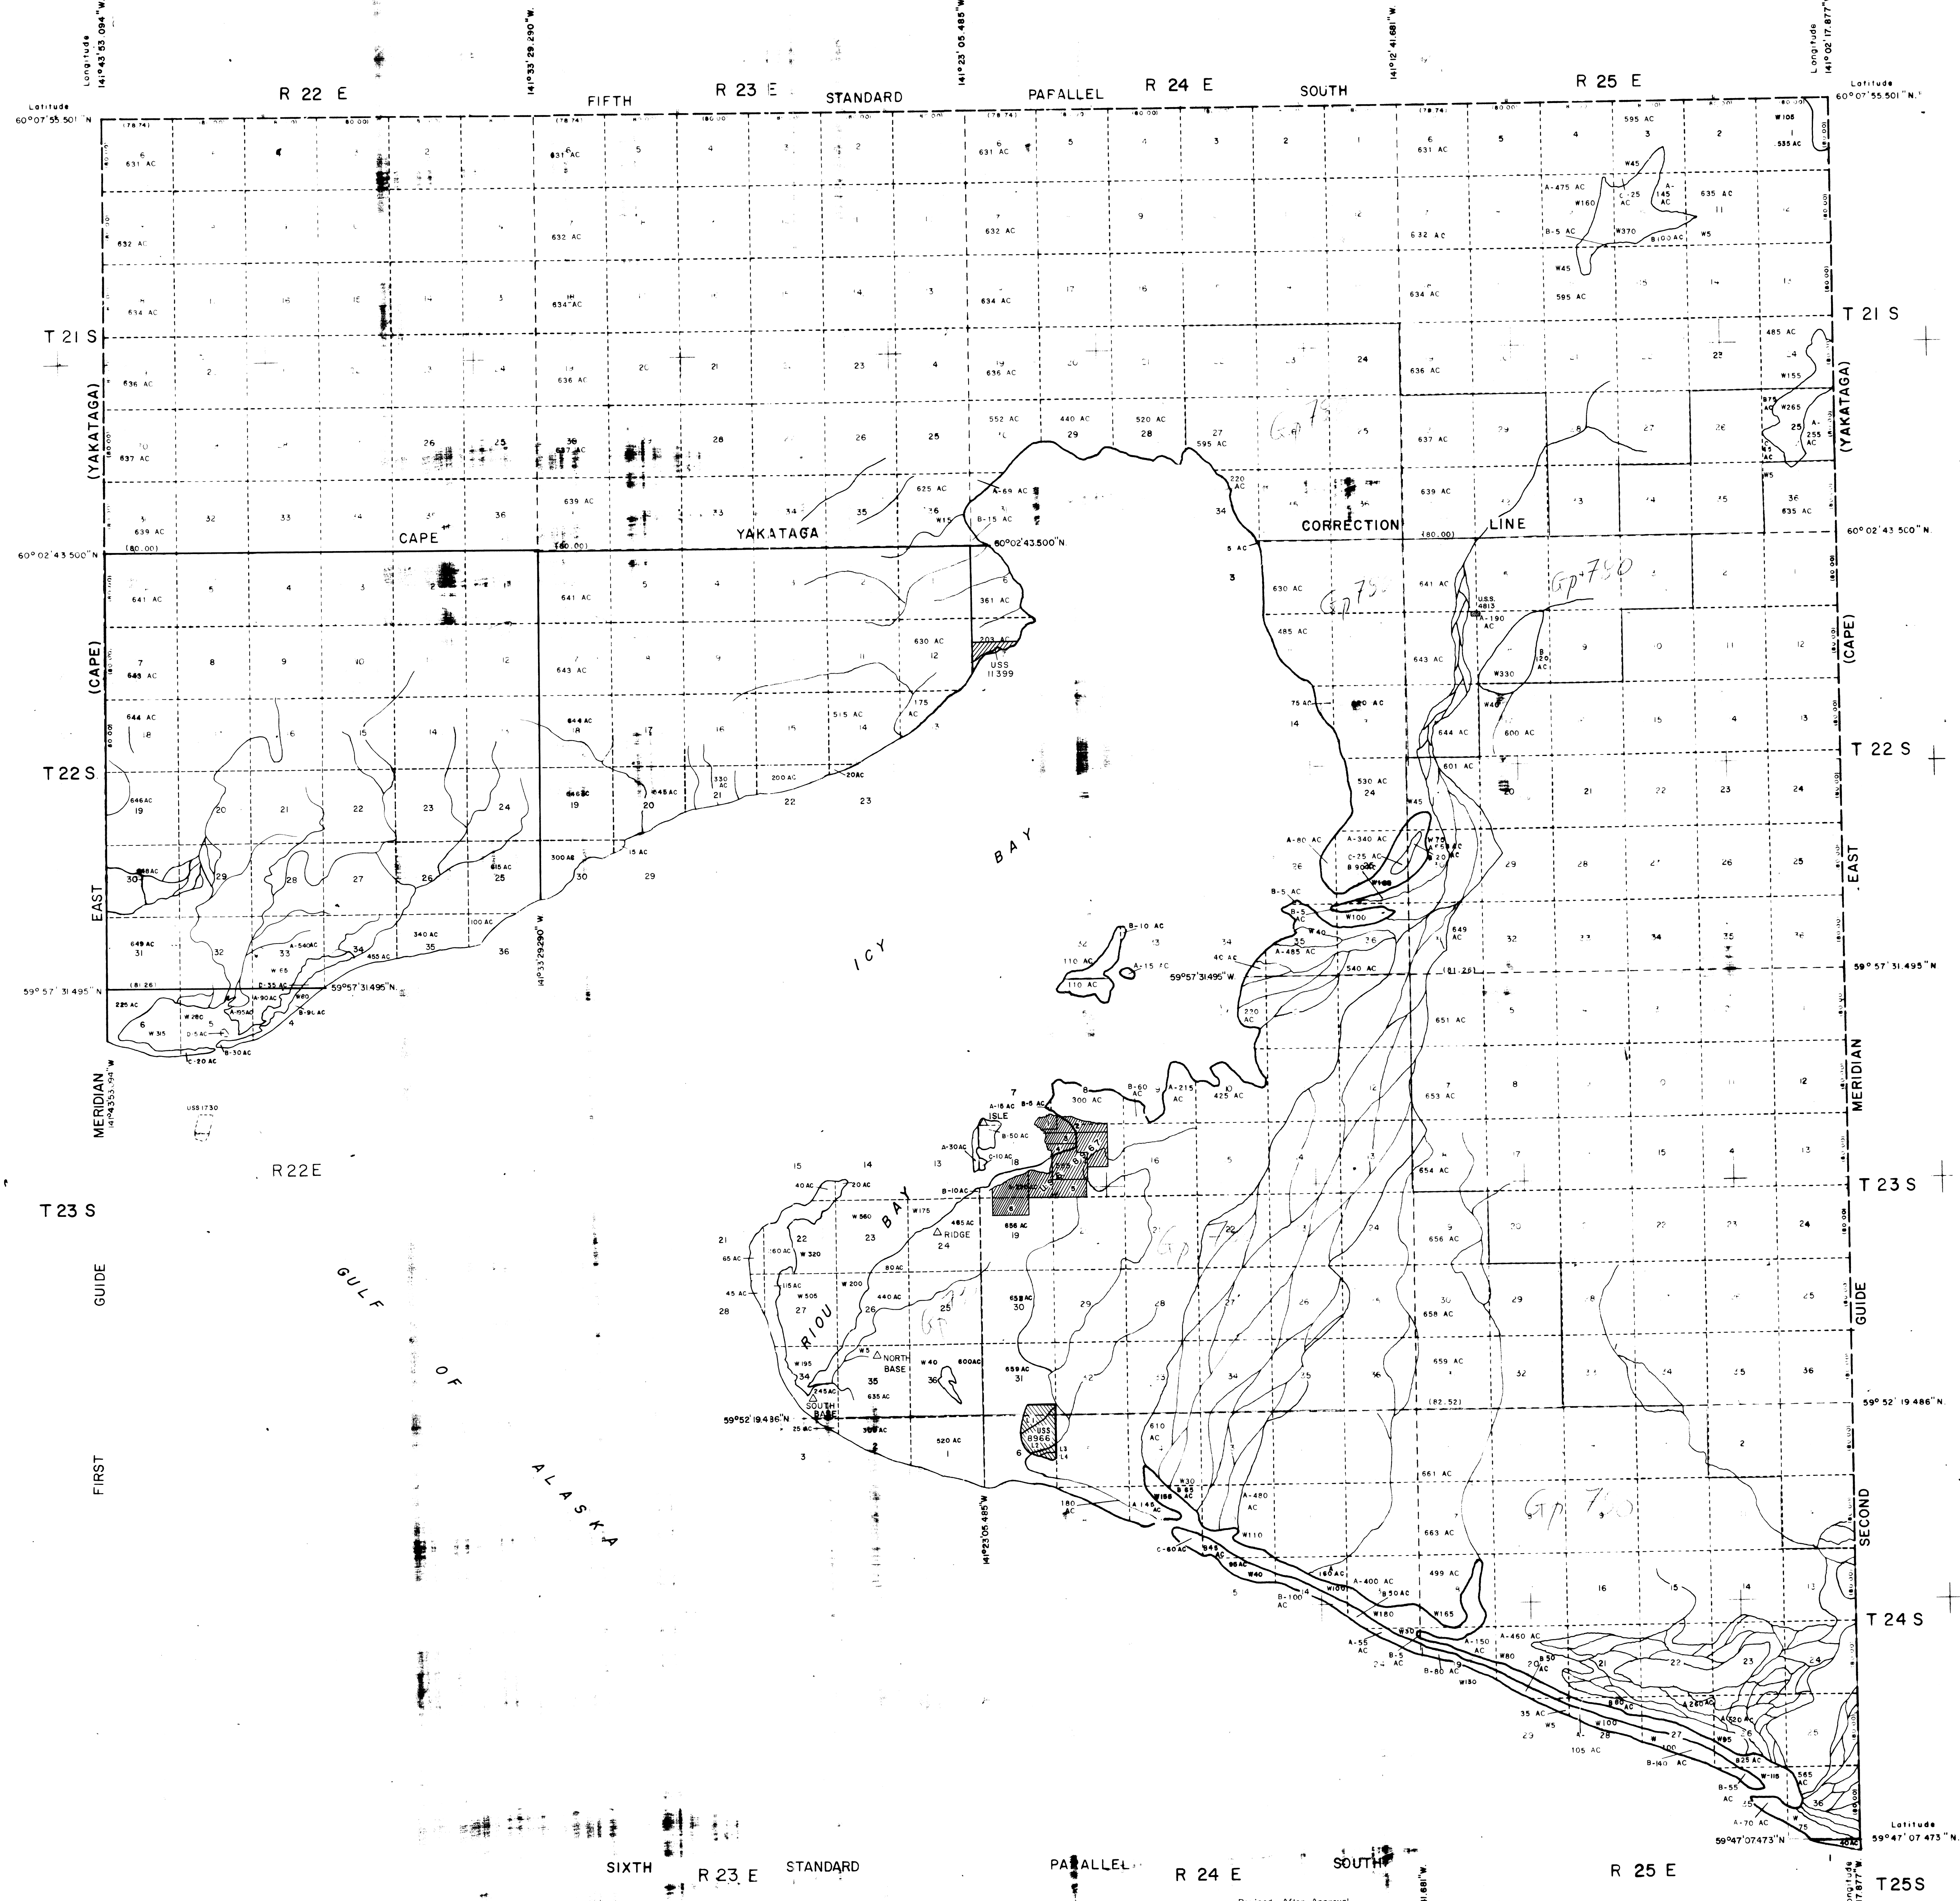

[Symbol] Surveyed. See official plats for areas.
 Unless otherwise shown each Section contains 640 acres.
 Fractional portions of land areas in each Section designated by letters A, B, C, etc.
 Water area in each Section designated by letter W.
 Water area based upon U.S.G.S. quadrangle sheets.
 Water areas shown on this diagram are computed to the nearest five acres only.

DRAINAGE RELIABILITY DIAGRAM

1	2	3	4
5	6	7	8
9	10	11	12
13	14	15	16

1 DRAINAGE FROM TOPOGRAPHIC QUADRANGLES 1:25,000 SERIES
 2 DRAINAGE FROM TOPOGRAPHIC QUADRANGLES 1:50,000 SERIES

Revised After Approval
 USS 4813 added Feb., 1967.
 80% of T.22 S. R. 22-24 W. & T.23 S. R. 22 W. added 10/78.
 USS 8967 added 12/87
 USS R398 added 12/88
 USS R398 added 12/88

UNITED STATES
 DEPARTMENT OF THE INTERIOR
 BUREAU OF LAND MANAGEMENT
 WASHINGTON D C MARCH 28, 1960

This diagram represents the official
 protraction of the rectangular system
 of surveys and is hereby approved

For the Director

 Donald O. Clement
 Cadastral Engineering Staff Officer

