


TOWNSHIPS 17 TO 20 SOUTH, RANGES 9 TO 11 1/2 EAST, COPPER RIVER MERIDIAN, ALASKA PROTRACTED (UNSURVEYED)

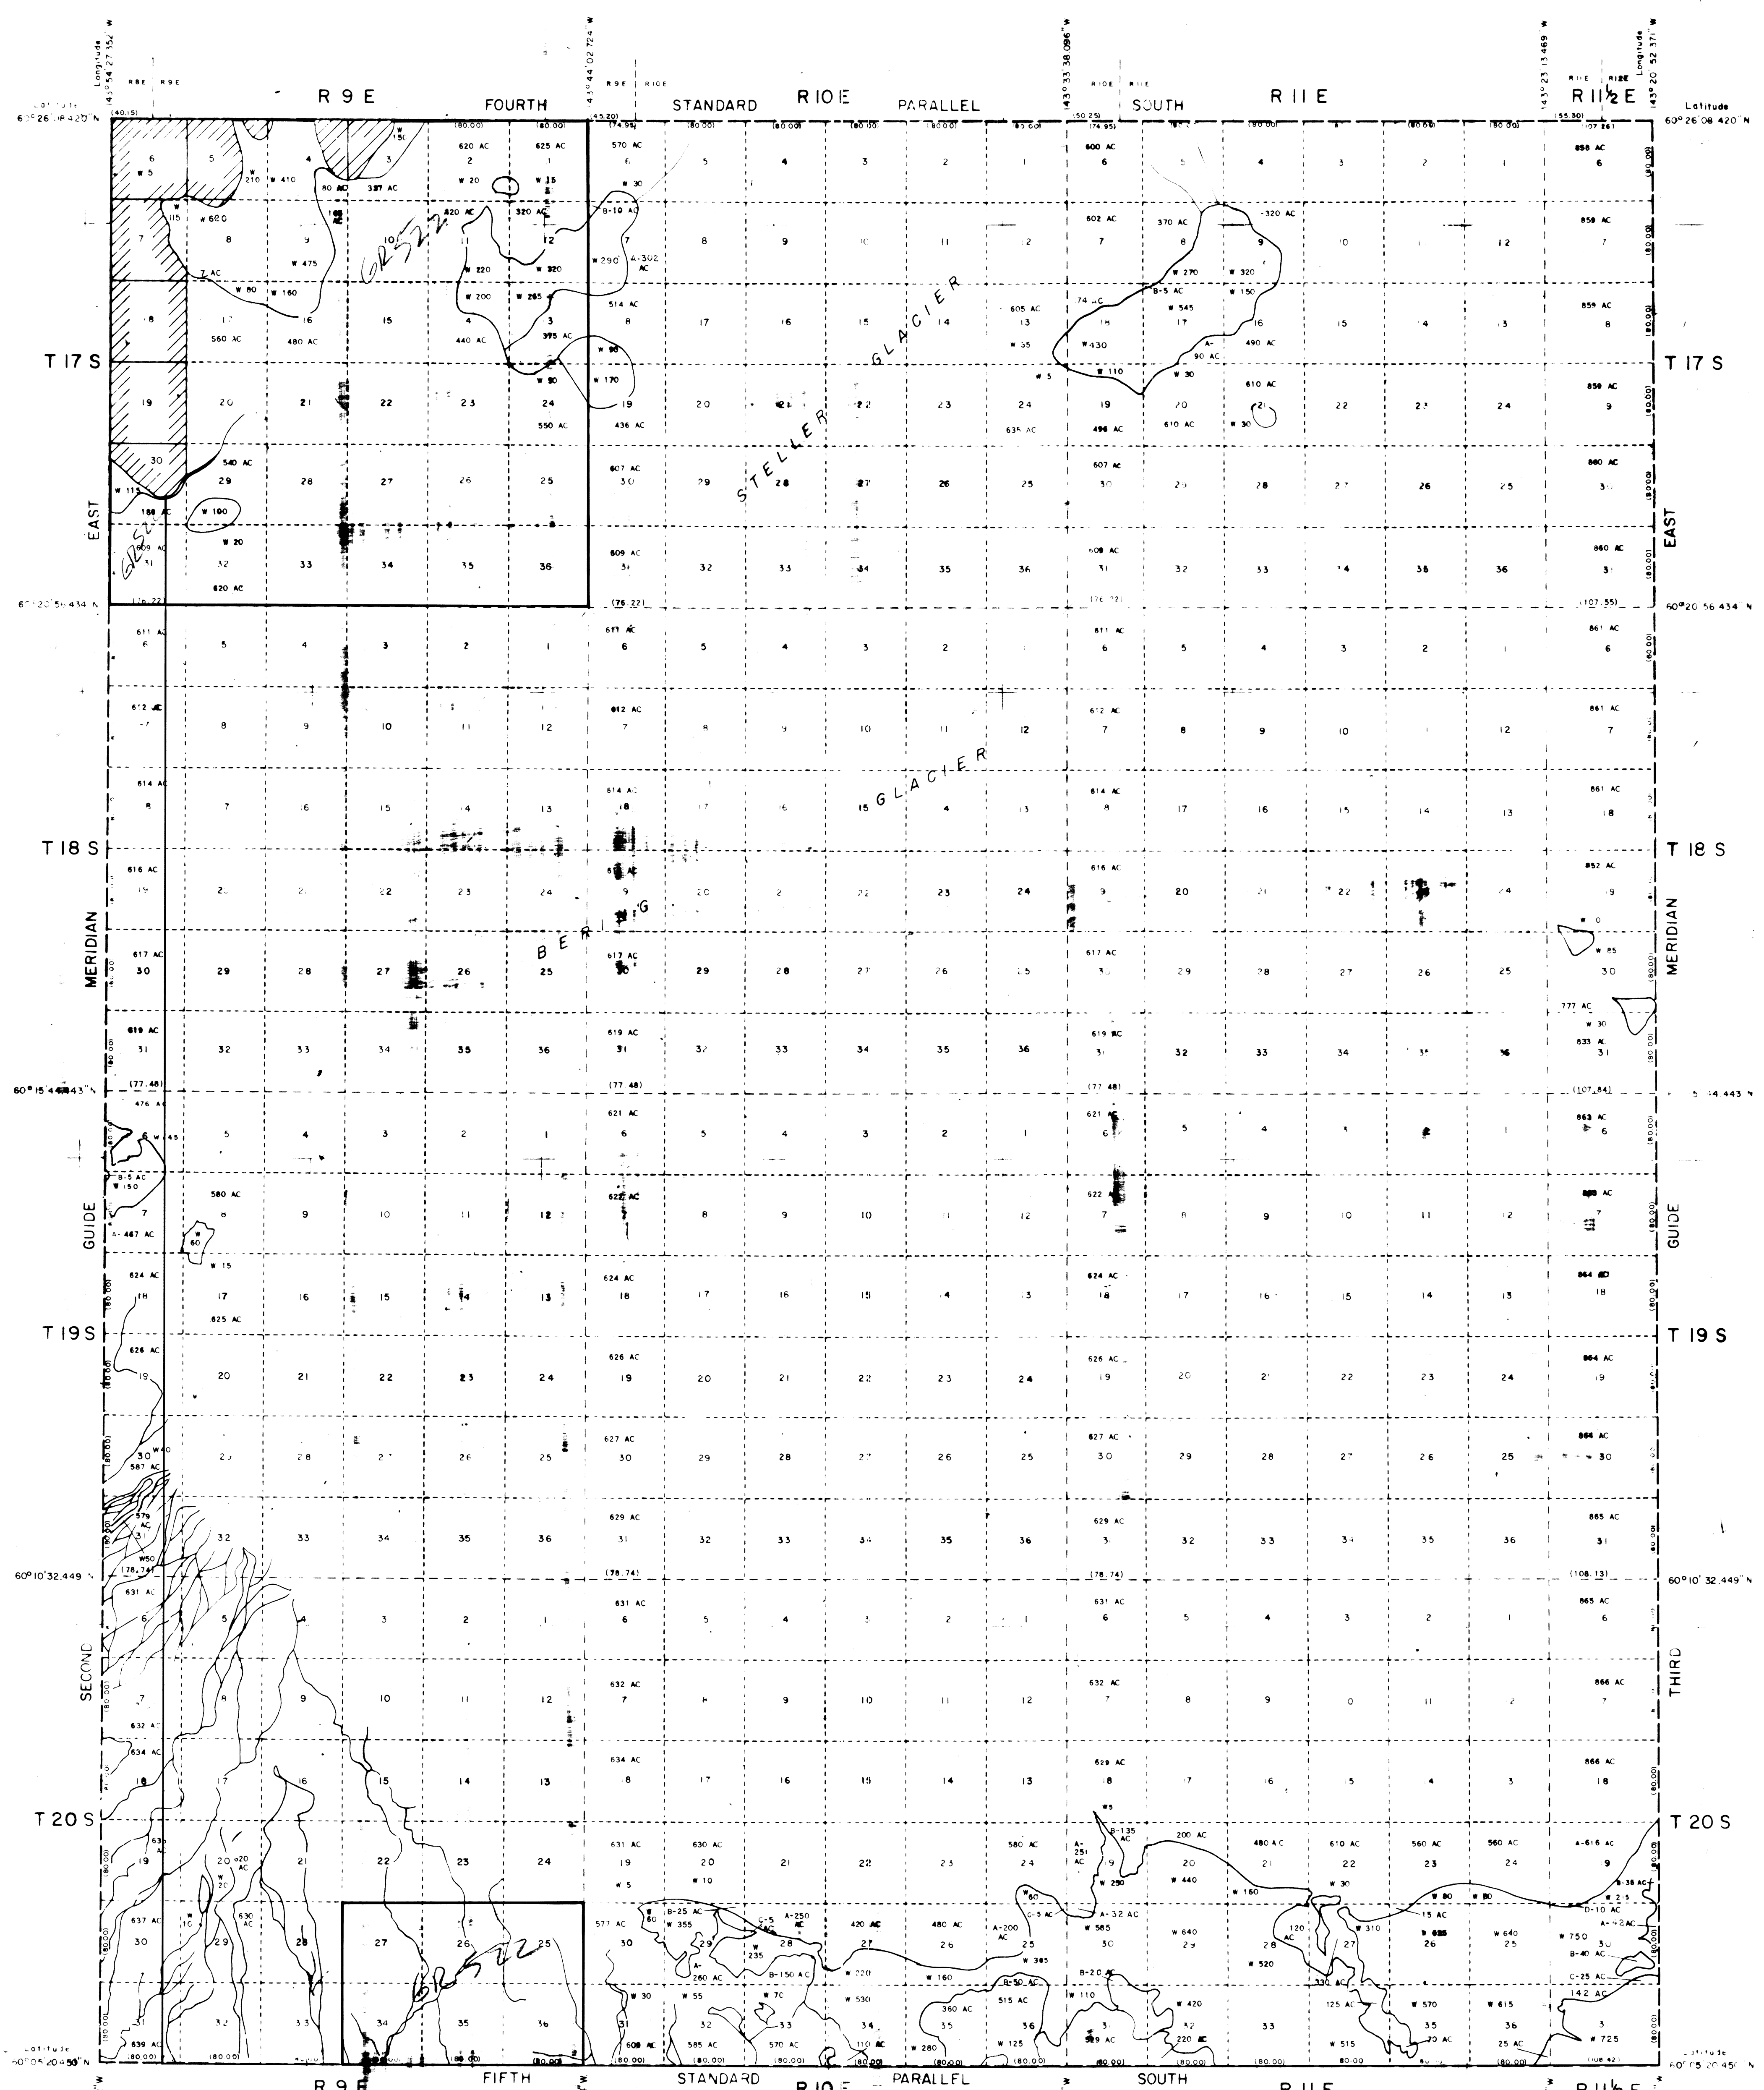


See official plats for areas.
 Unless otherwise shown, each section contains 640 acres.
 Fractional portions of these areas in each section are designated by letters A, B, C, etc.
 Water areas are designated by letter W.
 Water areas based upon U.S.G.S. quadrangle sheets.
 Water areas shown on this diagram are computed to the nearest five acres only.

DRAINAGE RELIABILITY DIAGRAM

1	2
3	4
5	6

MADE FROM TOPOGRAPHIC MAPS IN THE 1:50,000 SERIES
 DRAWN FROM TOPOGRAPHIC DIAGRAMS IN THE 1:50,000 SERIES
 DRAINAGE FROM SEMI-CONTROLLED WOODS (1957) PHOTOGRAPHY

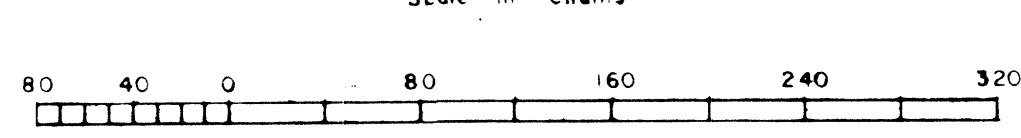

Revised After Approval
 Bds. of T.17S, R.9E & CHUGACH NAT'L FOREST BDRY. thru Ts. 17-20S, R.9E
 0664 10/78
 T20S, R.9E, SECS. 25-27 & 34-36 ADDED
 11/9/95

UNITED STATES
 DEPARTMENT OF THE INTERIOR
 BUREAU OF LAND MANAGEMENT
 WASHINGTON, D.C. APRIL 15, 1960

This diagram represents the official protraction of the rectangular system of surveys and is hereby approved

For the Director
Ronald Clement
 Cadastral Engineering Staff Officer