



TOWNSHIPS 17 TO 20 SOUTH, RANGES 5 TO 8 EAST, COPPER RIVER MERIDIAN, ALASKA PROTRACTED (UNSURVEYED)

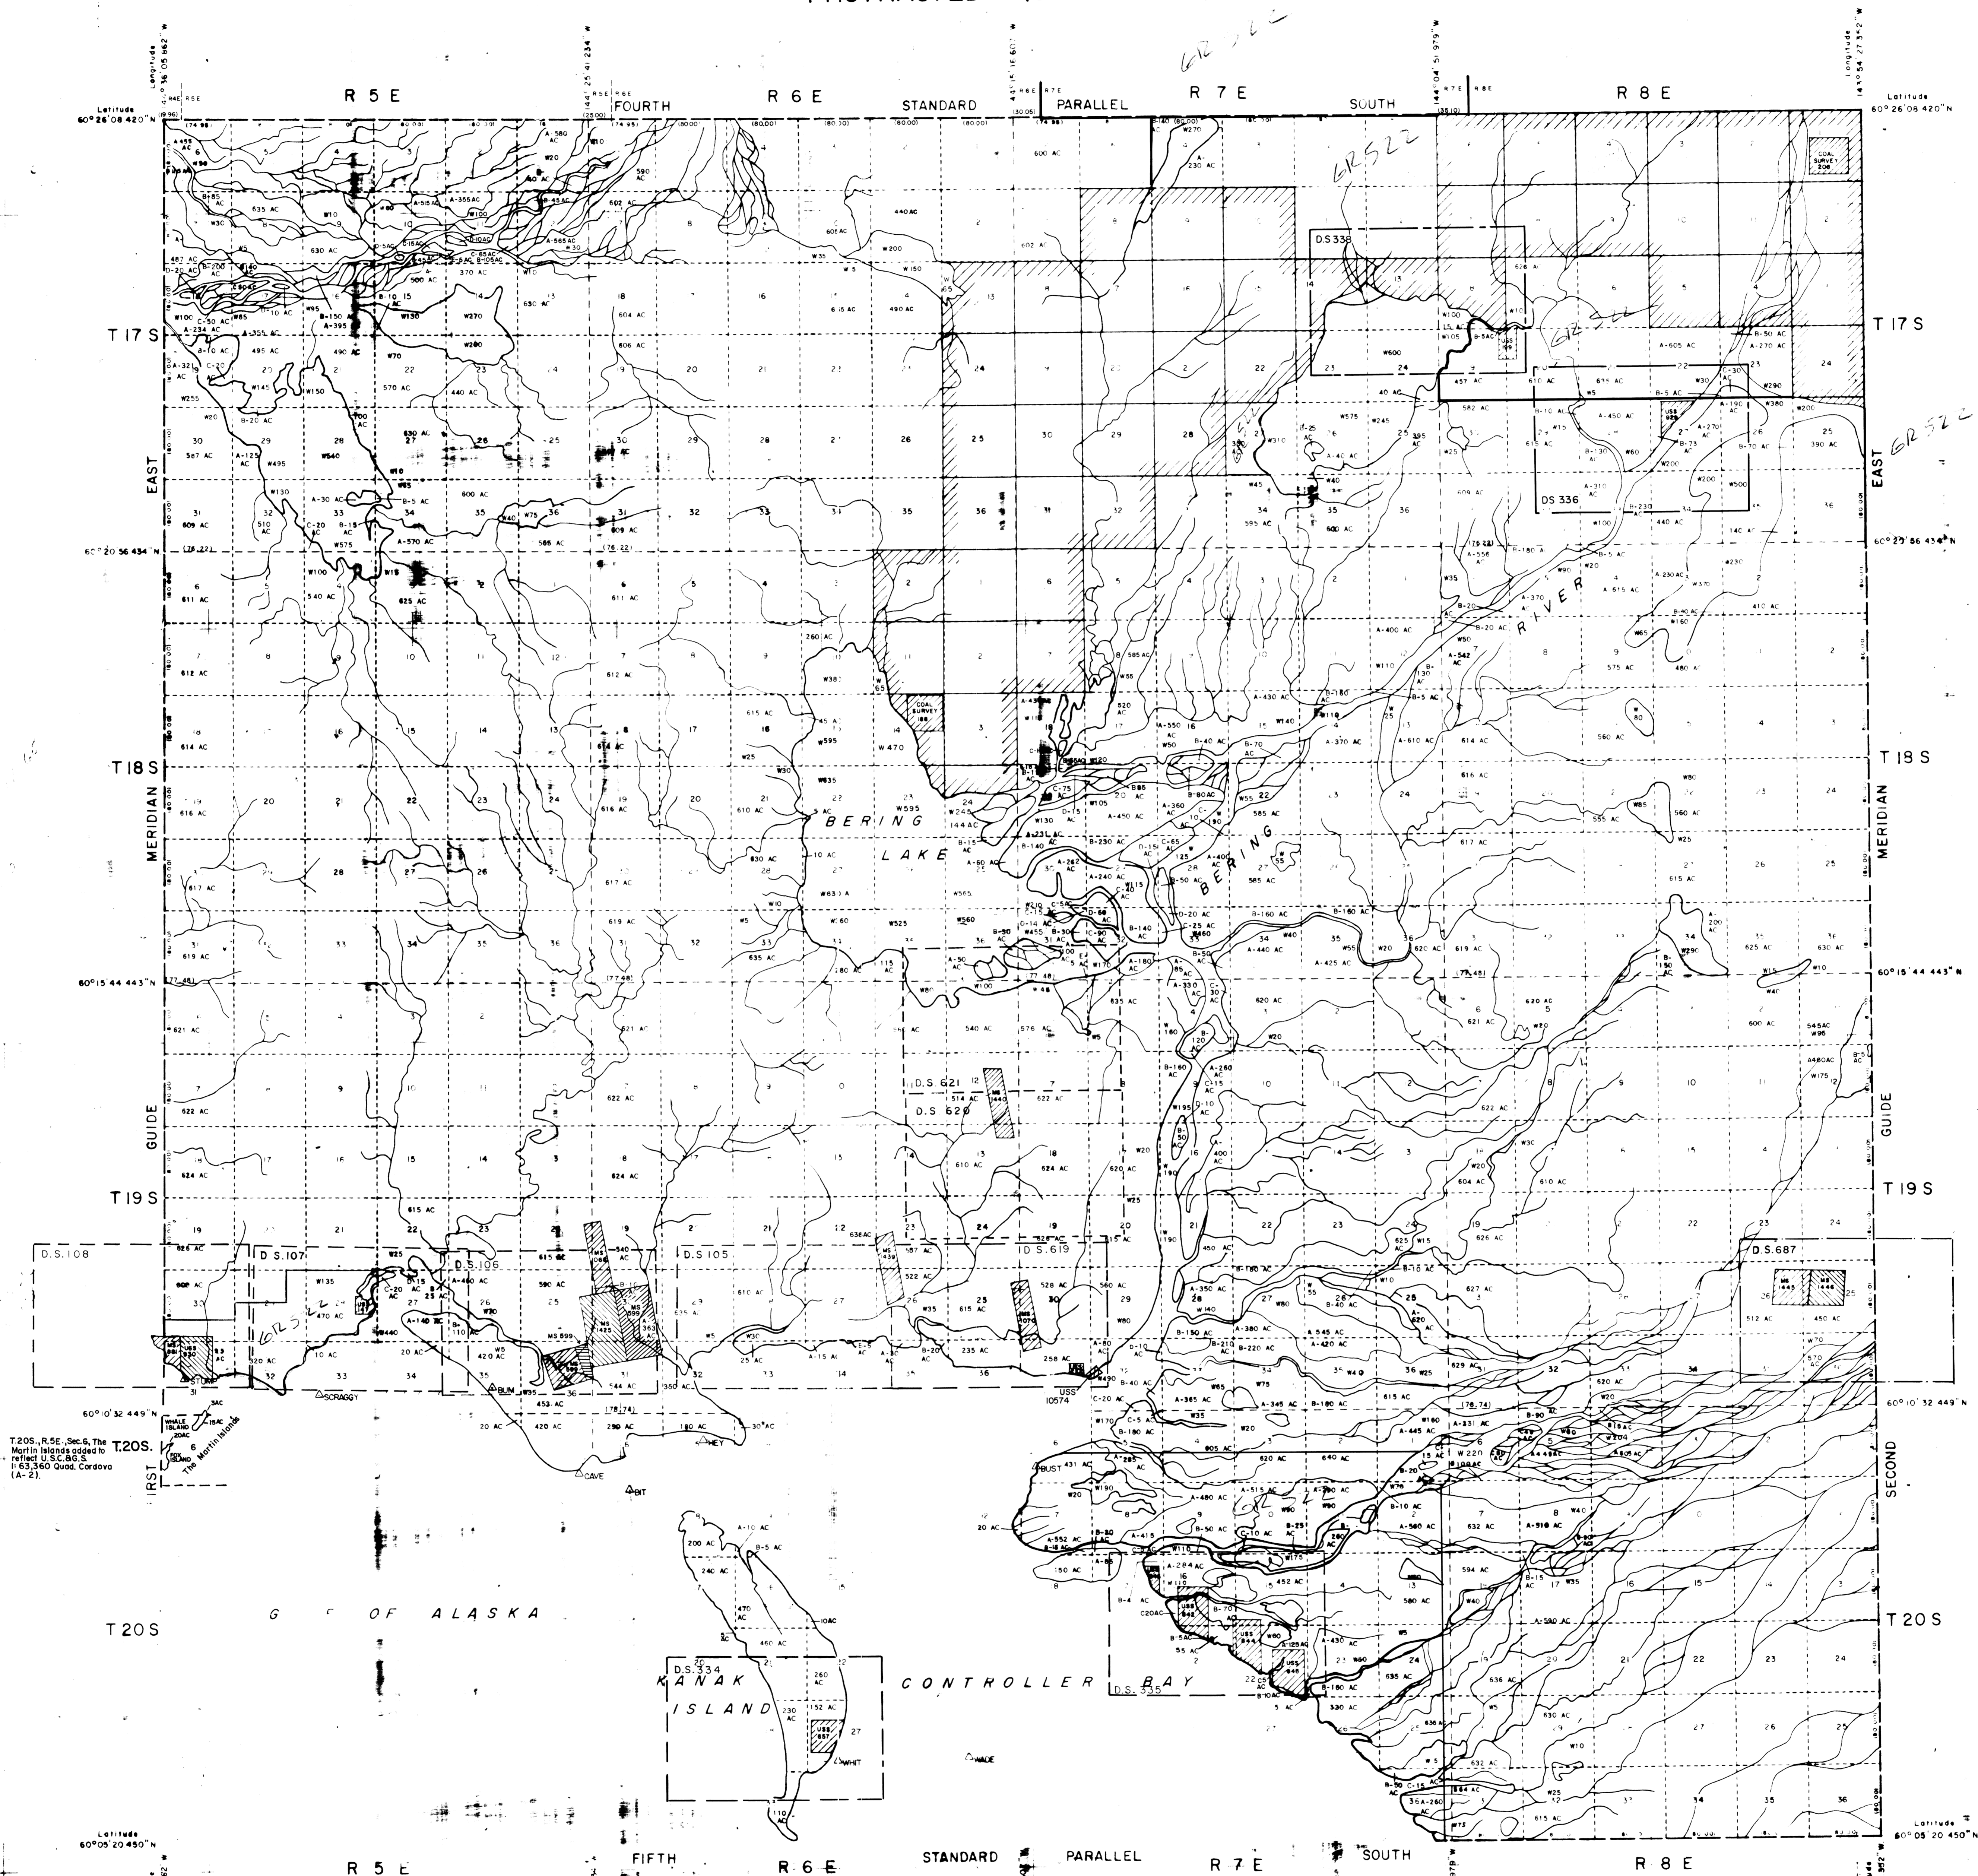

T.20S, R.5E, Sec.6, The
Mortin Islands added to
revised U.S.G.S. B.S.
1:63,360 Quad, Cordova
(A-2).

T.20S

Surveyed. See official plots for areas.
Unless otherwise shown each section contains 640 acres.
Fractional portions of land areas in each section
designated by letters A, B, C, etc.
Water area in each section designated by letter W.
Water area based upon U.S.G.S. quadrangle sheets.
Water areas shown on this diagram are computed
to the nearest five acres only.

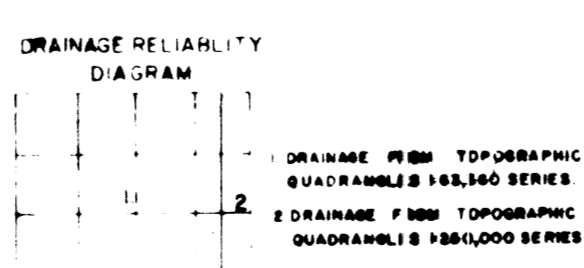

Revised After Approval
District Sheets 105, 106, 107, 108,
334, 335, 619, 620, & 621
Added June, 1965
District Sheet 336 & 338 added Nov
1965
Mineral Survey No. 599, claim nos 3, 9
and 10 added July, 1972.
The Mortin Islands group along with T. 20
S., R. 5 E., Sec. 6 as depicted on U.S.G.S.
B.S. 1:63,360 quad, Cordova (A-2)
Added 1969 or 1971. March 1965
USS 10574 added 11/6/95
T.T.S. REC. SURVEYED LINE ADDED 11/9/95
T.T.S. 9 20S, R. 7E, SURVEYED LINES ADDED 11/13/95

UNITED STATES
DEPARTMENT OF THE INTERIOR
BUREAU OF LAND MANAGEMENT

WASHINGTON, D.C., APRIL 15, 1960

This diagram represents the official
protraction of the rectangular system
of surveys and is hereby approved

For the Director

Donald C. ...
Cadastral Engineering Staff Officer

