


# CALCULATION DIAGRAM

293

Township 28 North, Range 25 West, Kateel River Meridian, Alaska

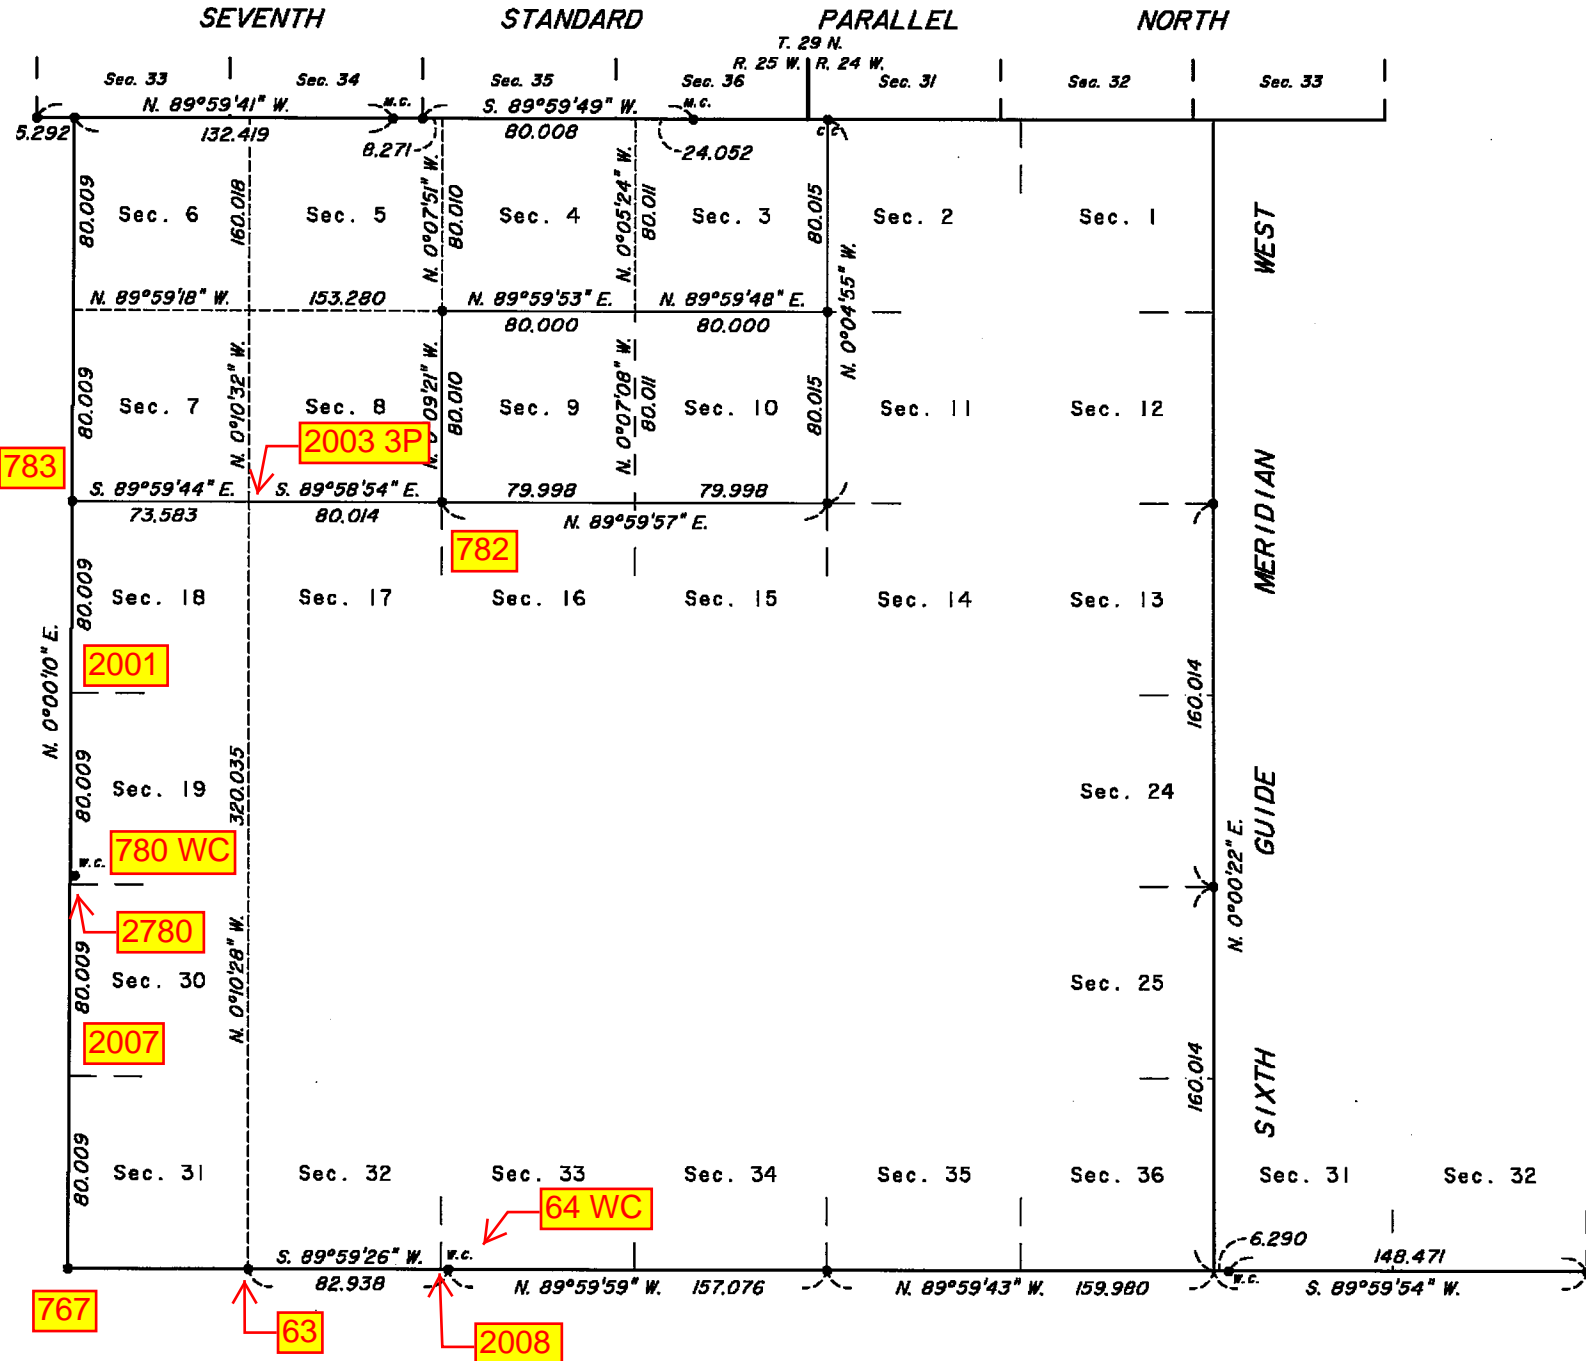

This diagram reports bearings and distances to the controlling positions defined by the relationship of identified recovered corners with the protracted lines shown on the official plat of survey accepted December 28, 1978.

Distances are shown to the nearest 0.001 chain and bearings to the nearest second on this diagram, however the information reported on the plat and in the field notes has been rounded to the nearest 0.01 chain and nearest minute of arc.