
TOWNSHIP I SOUTH, RANGE 2 WEST OF THE FAIRBANKS MERIDIAN, ALASKA

SHEET No. 3 OF 3 SHEETS

DEPENDENT RESURVEY AND SUBDIVISION OF SECTIONS 12, 13, 14 AND 23 SECTION 23

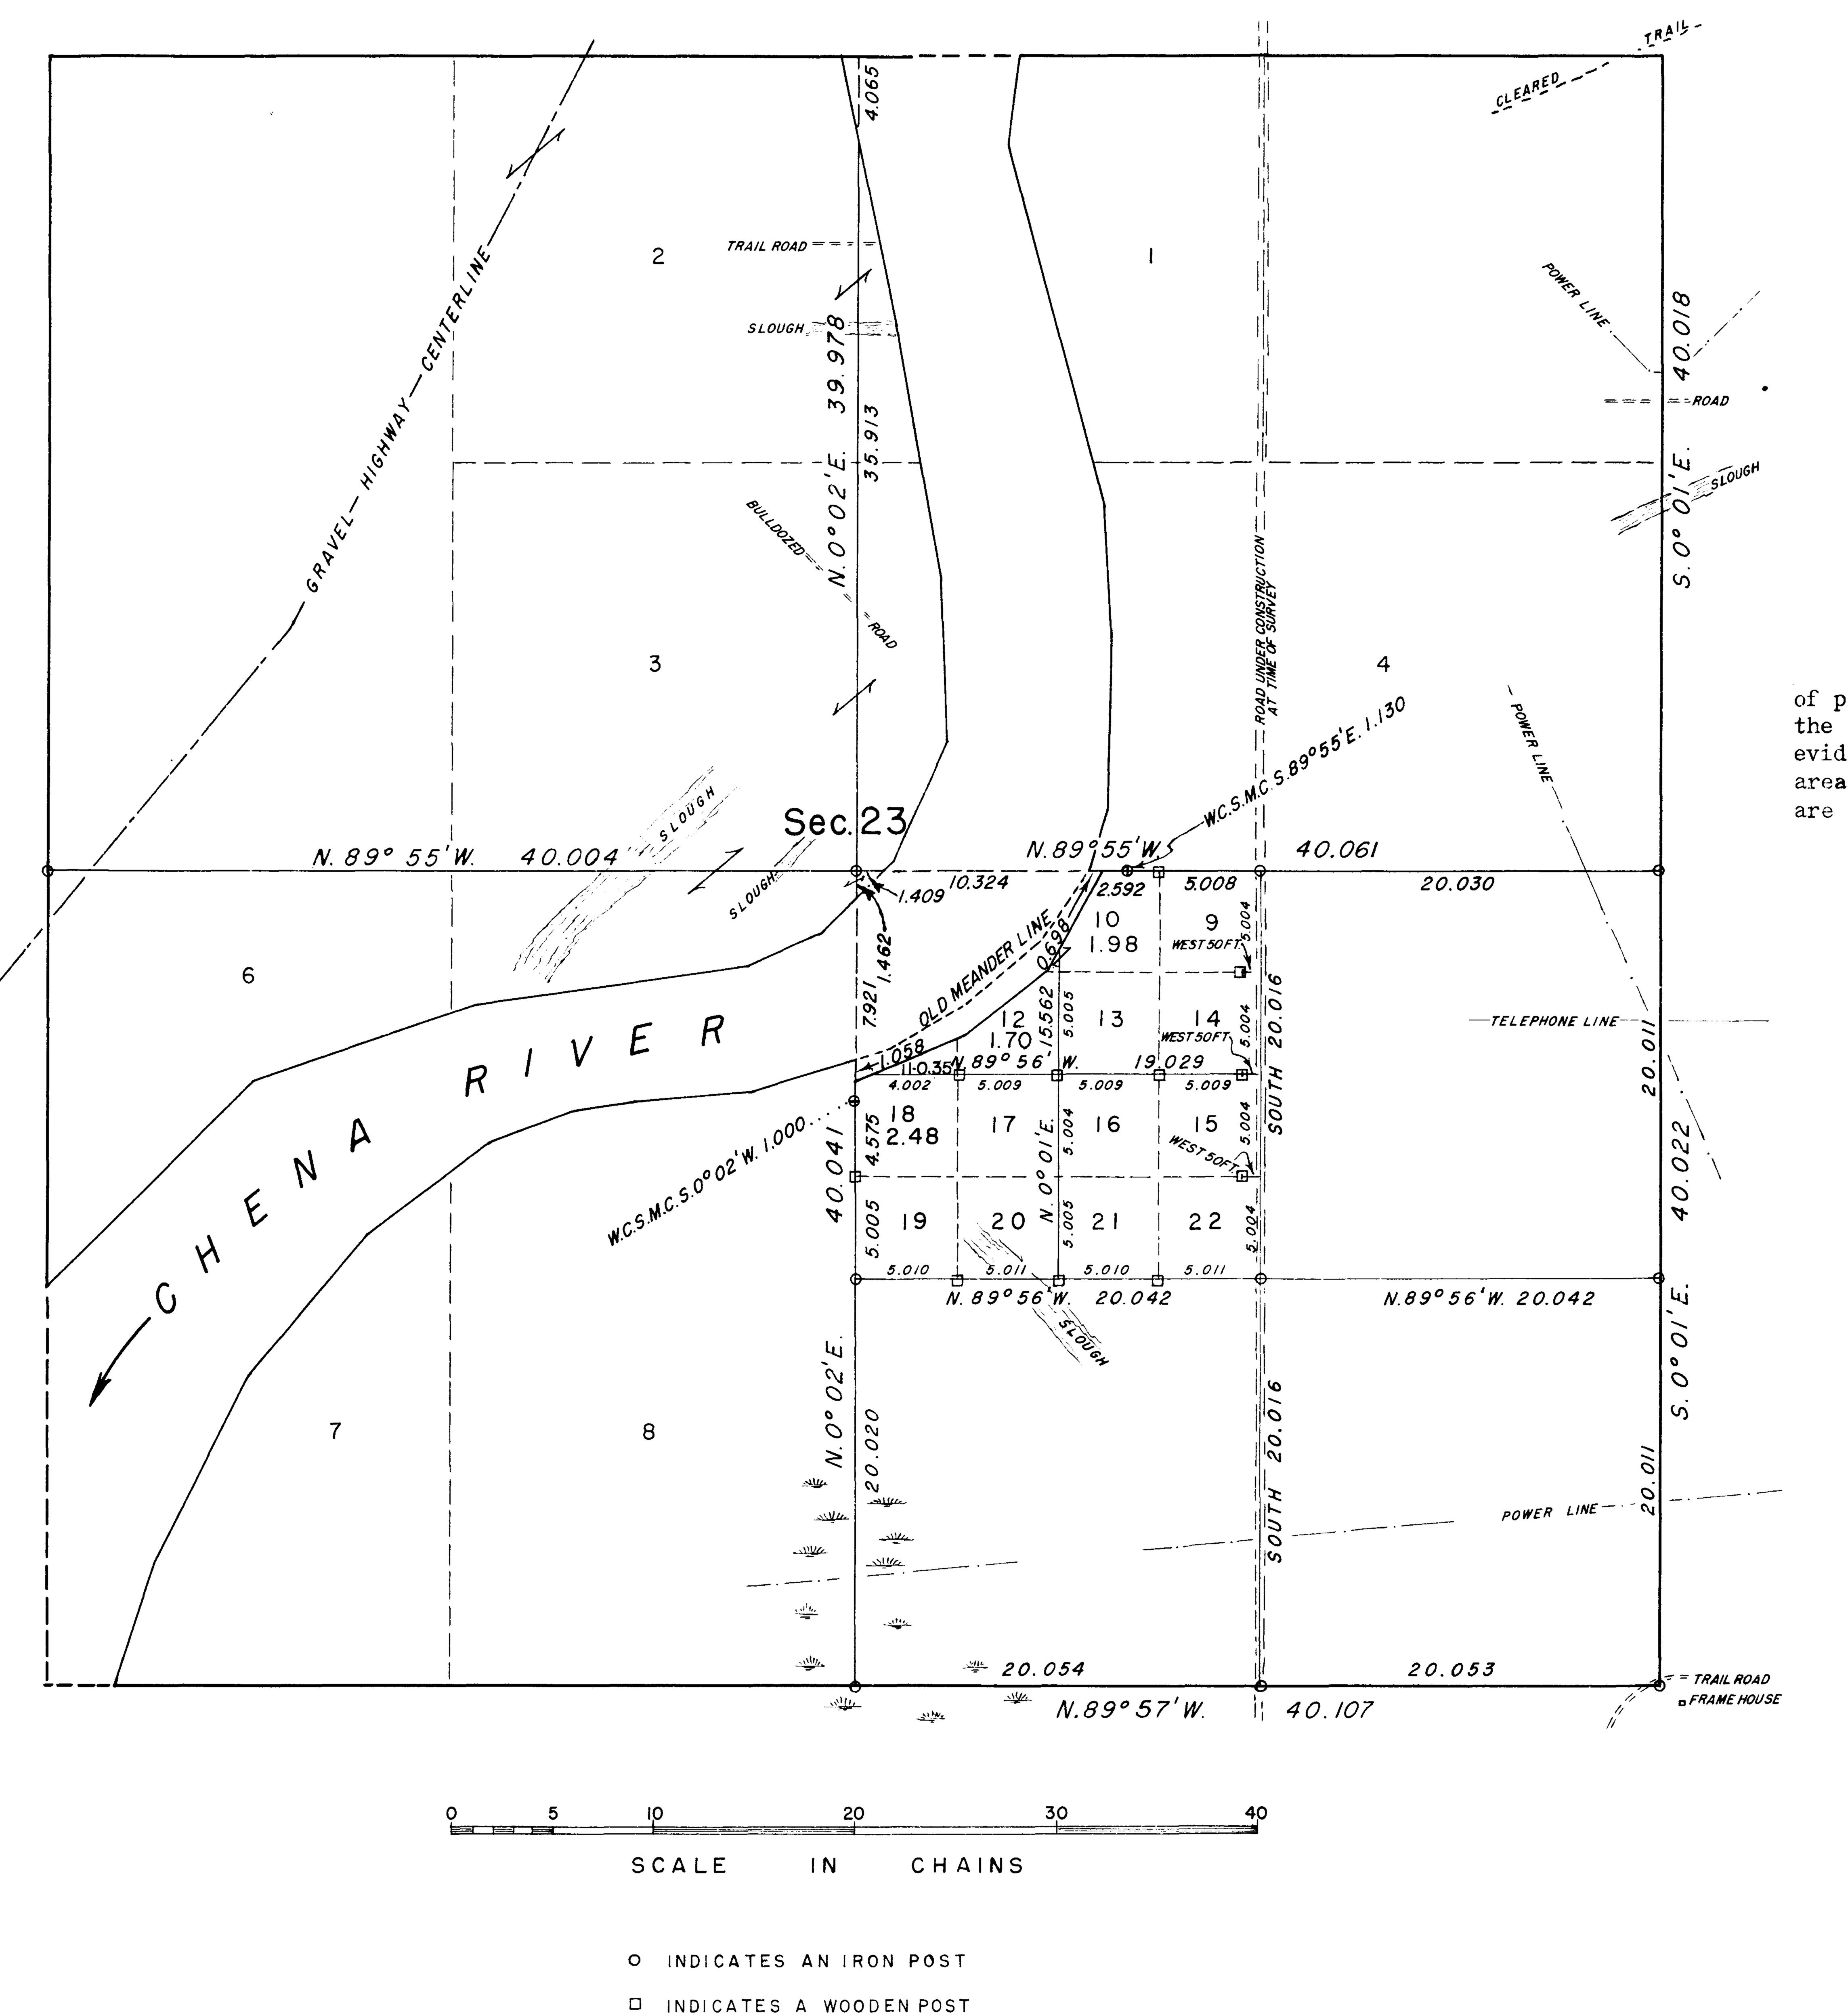

This plat, in 3 sheets, represents a retracement and reestablishment of portions of the east boundary and subdivisional lines designed to restore the corners in their original locations according to the best available evidence, and a partial subdivision of certain sections, The lottings and areas are as shown on the plat approved June 7, 1913, except as new areas are indicated hereon.

Survey executed by Lloyd E. Toland, Cadastral Engineer, July 21 to October 5, 1951, under Special Instructions for Group 49 Alaska, dated April 27, 1934.

Area Resurveyed: 151.51 Acres

All new lots shown on this sheet without areas, each contain 2.50 acres.

UNITED STATES DEPARTMENT OF THE INTERIOR BUREAU OF LAND MANAGEMENT Washington, D. C., May 4, 1953

This plat is strictly conformable to the approved field notes, and the survey, having been correctly executed in accordance with the requirements of law and the regulations of this Bureau, is hereby accepted.

For the Administrator

Dances 630ement

Assistant Chief, Division of Cadastral Engineering