



Revised 2/10
DNR 10-162V
MTRSC

Amended STATE OF ALASKA Associated Document #
DEPARTMENT OF NATURAL RESOURCES 2018-000437-0
STATE MINING LOCATION NOTICE / CERTIFICATE
Federal (FOR MTRSC CLAIMS ONLY) Placer Claim



CLAIM NAME/NUMBER: Bean Creek Mine
AA095311

DISCOVERY DATE: 4/28/18

LOCATOR INFORMATION:
(The locator is the owner. Print the Name / Address below
where correspondence should be sent):

POSTING DATE: 4/29/18

1. Owner's Name: Catherine Felt
Mailing Address: 1011 First St.
City, State Zip: Kenai AK, 99611
Contact Phone: (907) 741-0336

SIZE OF CLAIM 19.875 (check one)
acres
FULL Quarter Section (160 acres): _____
Quarter-Quarter Section (40 acres) _____

RECORDING DISTRICT:
Seward

ADDITIONAL LOCATOR'S / OWNER'S (PRINT)

LEGAL DESCRIPTION:
Give the complete legal description below.

2. Owner's Name: Kyle Felt
Mailing Address: 1011 First St.
City, State Zip: Kenai AK, 99611
Contact Phone: (607) 857-4613

Meridian: Seward
Township: 5N
Range: 3W
Section: 19
Quarter Section: SW


3. Owner's Name: _____
Mailing Address: _____
City, State Zip: _____
Contact Phone: _____

Qtr-Qtr Section (if 40 acres) _____ of _____
Feet long in N-S direction: 1315ft
CREEK NAME: (optional) _____
Feet Wide in E-W direction: 658ft

ALL OWNERS OR THEIR AGENTS MUST SIGN:
I hereby certify that, on the date above, a location notice
was posted on the monument at the NE corner of this claim,
to the best of my knowledge, in accordance with applicable
State statutes and regulations.

CLAIM SKETCH:
(See instructions on reverse side.)
Optional In place of the claim sketch below, a
separate map showing the location of this site is:

1. Owner / Agent: Catherine Felt
2. Owner / Agent: Kyle Felt
3. Owner / Agent: _____
Print
Agent's Name: _____

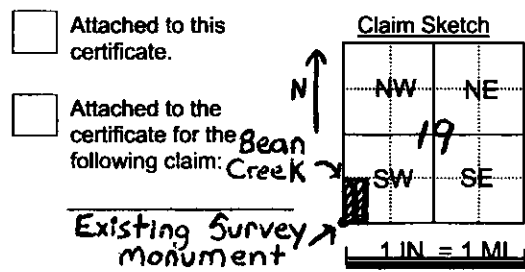

Attach an extra sheet for Additional Owners and Signatures

\$140.00 Qtr Section of a Township First Rental.
 \$ 35.00 Qtr-Qtr Sec. of a Township First Rental.
Due Within 45 Days Of Posting.

Div of Mining, Land & Water Use:
ADL