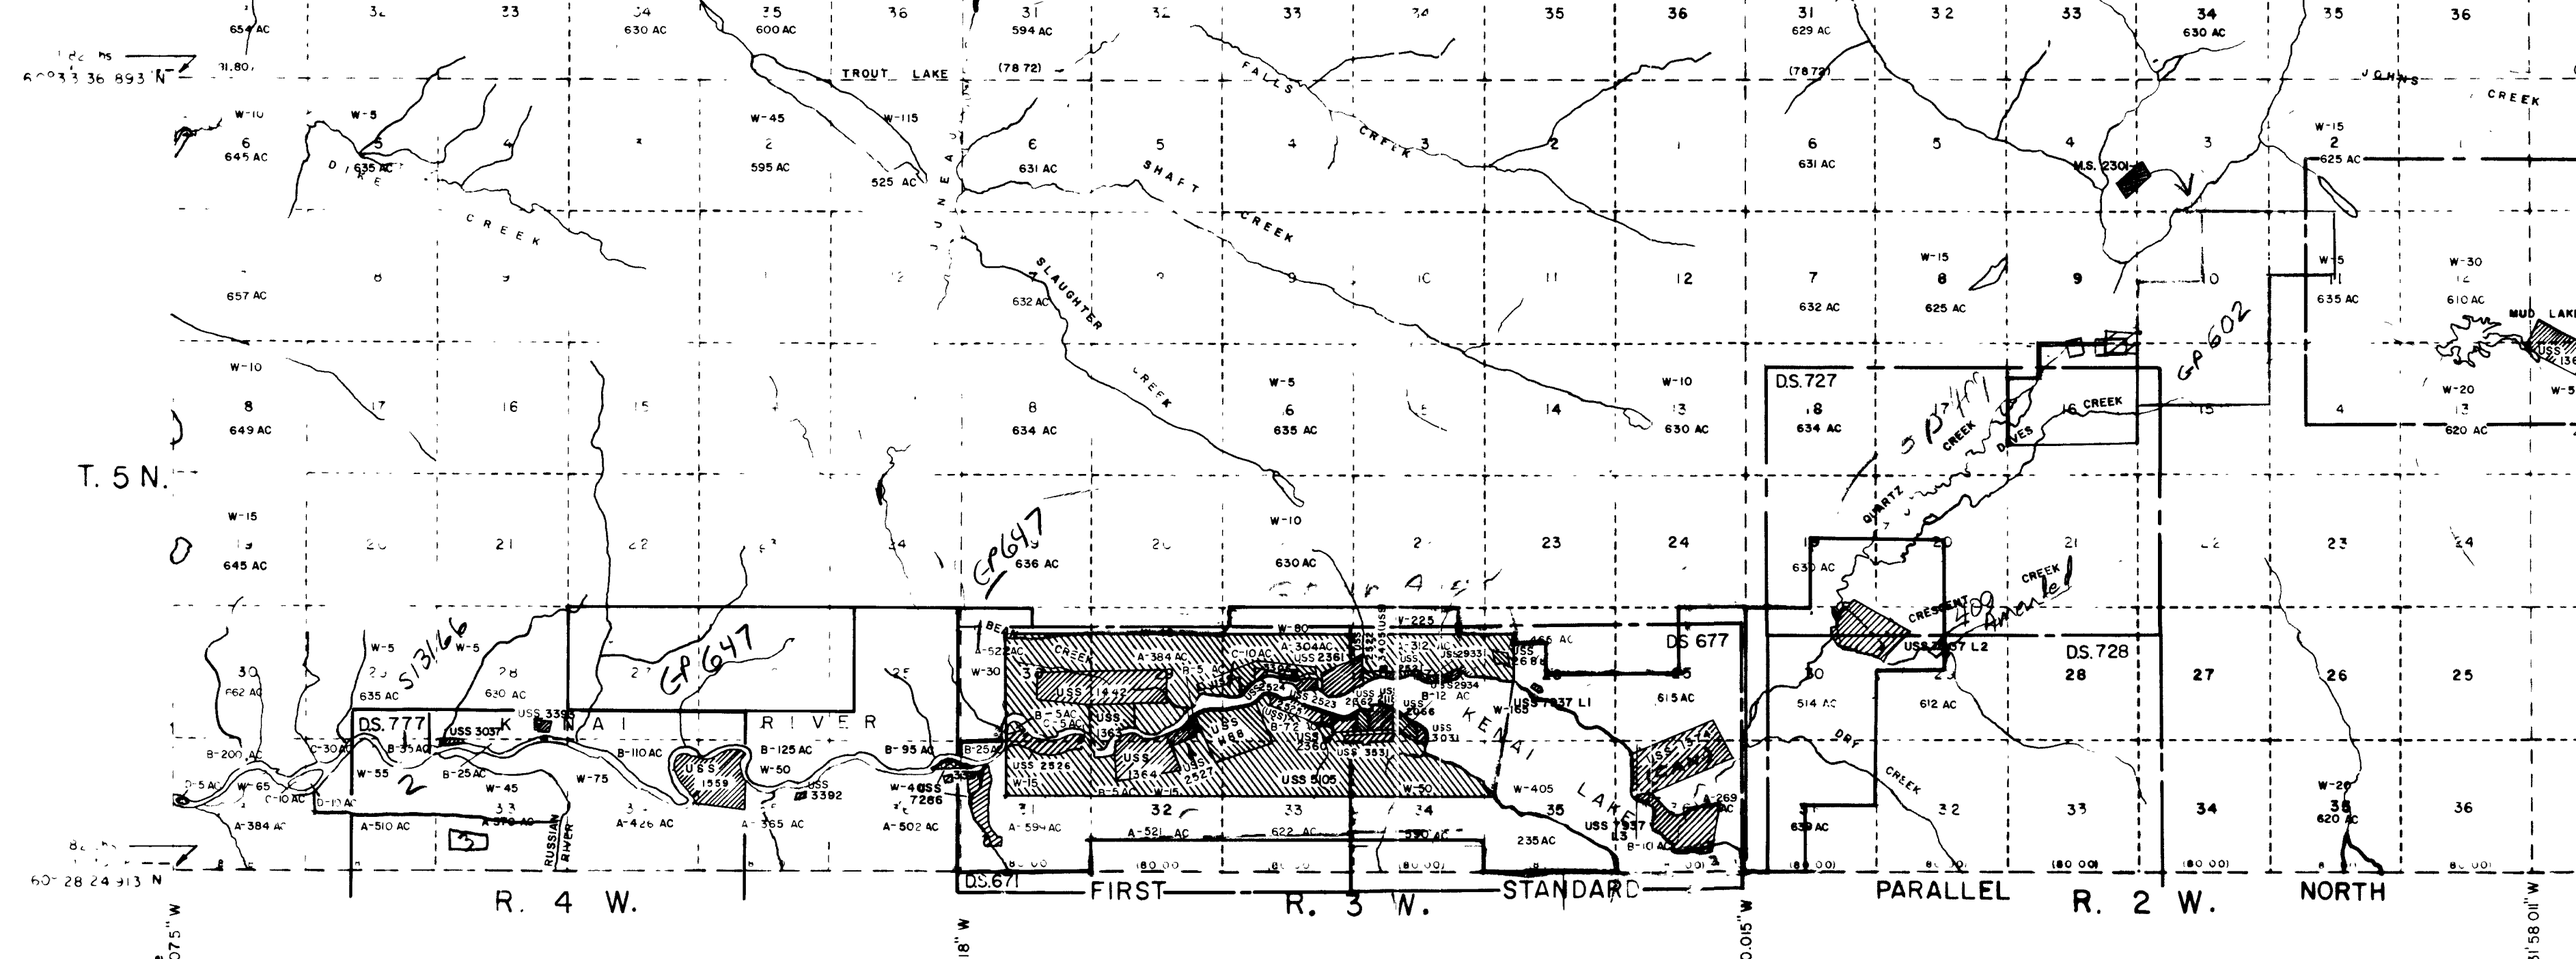

Surveyed. See official plats for areas.
Unless otherwise shown, each Section contains 640 acres.
Fractional portions of and areas in each Section are designated by letters A, B, C, etc.

DRAINAGE FROM TOPOGRAPHIC QUADRANGLES 1:63,360 SERIES

Note:

This diagram supercedes the diagram approved October 27, 1959.

DEPART
BUREA
WASHINGT
This
protraction
of surveys