


TOWNSHIPS 5 TO 8 NORTH, RANGES 5 TO 8 WEST, SEWARD MERIDIAN, ALASKA  
PROTRACTED (UNSURVEYED)

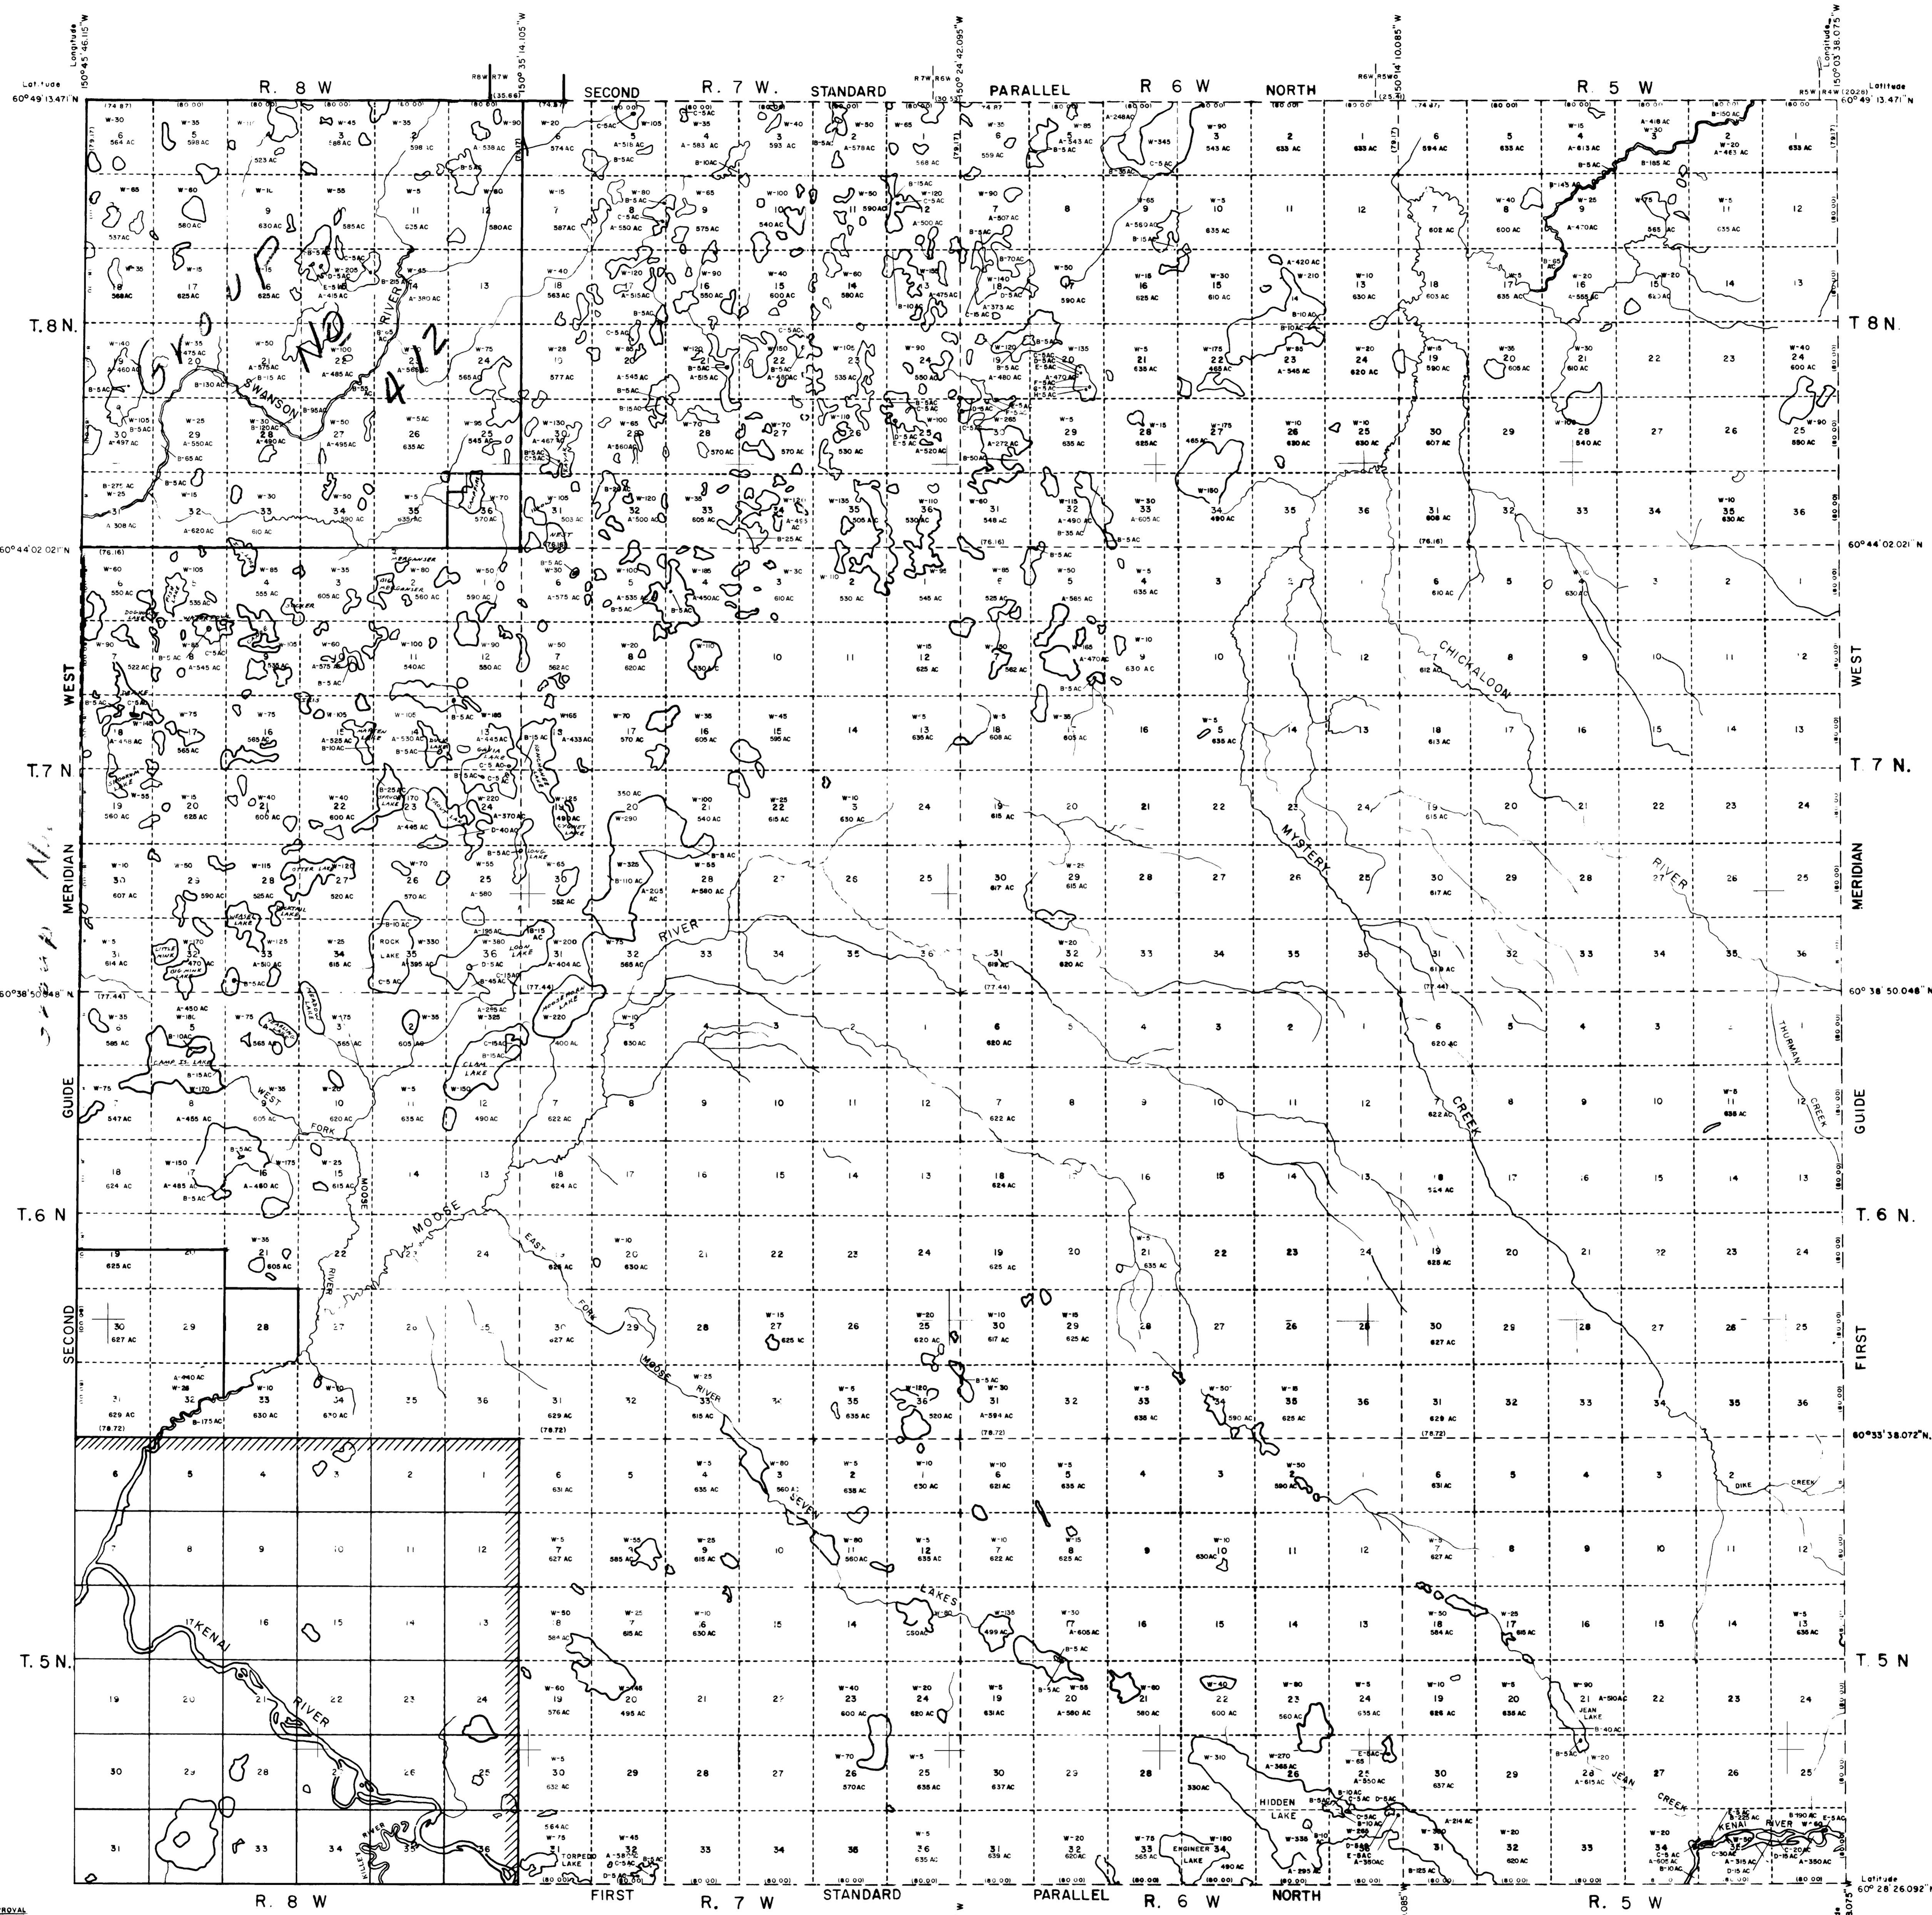


REVISED AFTER APPROVAL  
 T. 6 N. R. 8 W. added 5/13/92  
 T. 8 N. R. 8 W. added 5/13/92

Surveyed See official plats for areas.  
 Unless otherwise shown each Section contains 640 acres.  
 Fractional portions of land areas in each Section  
 designated by letters A, B, C, etc.  
 Water area in each Section designated by letter W  
 Water area based upon USGS quadrangle sheets.  
 Water areas computed to nearest five acres.

DRAINAGE FROM TOPOGRAPHIC  
 QUADRANGLES 1:62,500 SERIES

Note:  
 This diagram supercedes  
 the diagram approved  
 October 27, 1959.

Scale in Chains

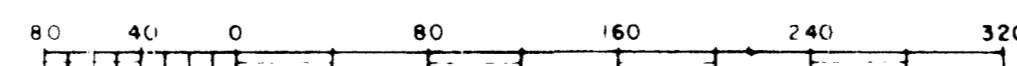

UNITED STATES  
 DEPARTMENT OF THE INTERIOR  
 BUREAU OF LAND MANAGEMENT

WASHINGTON D.C. MAY 8, 1963

This diagram represents the official  
 protraction of the rectangular system  
 of surveys and is hereby approved.

For the Director

*E. J. Hamilton*  
 Chief Division of Engineering

